



Location Plan 1:2500


© Crown Copyright 2024. All rights reserved. Licence number: 1000202

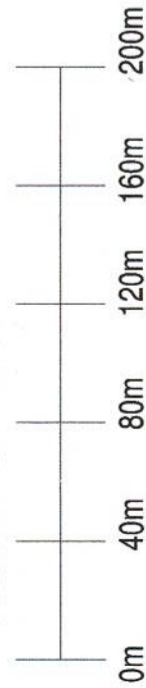

1: 2500 scale bar at A3

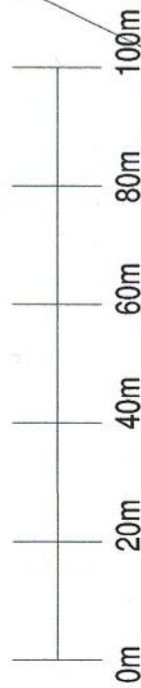

1: 1250 scale bar at A3

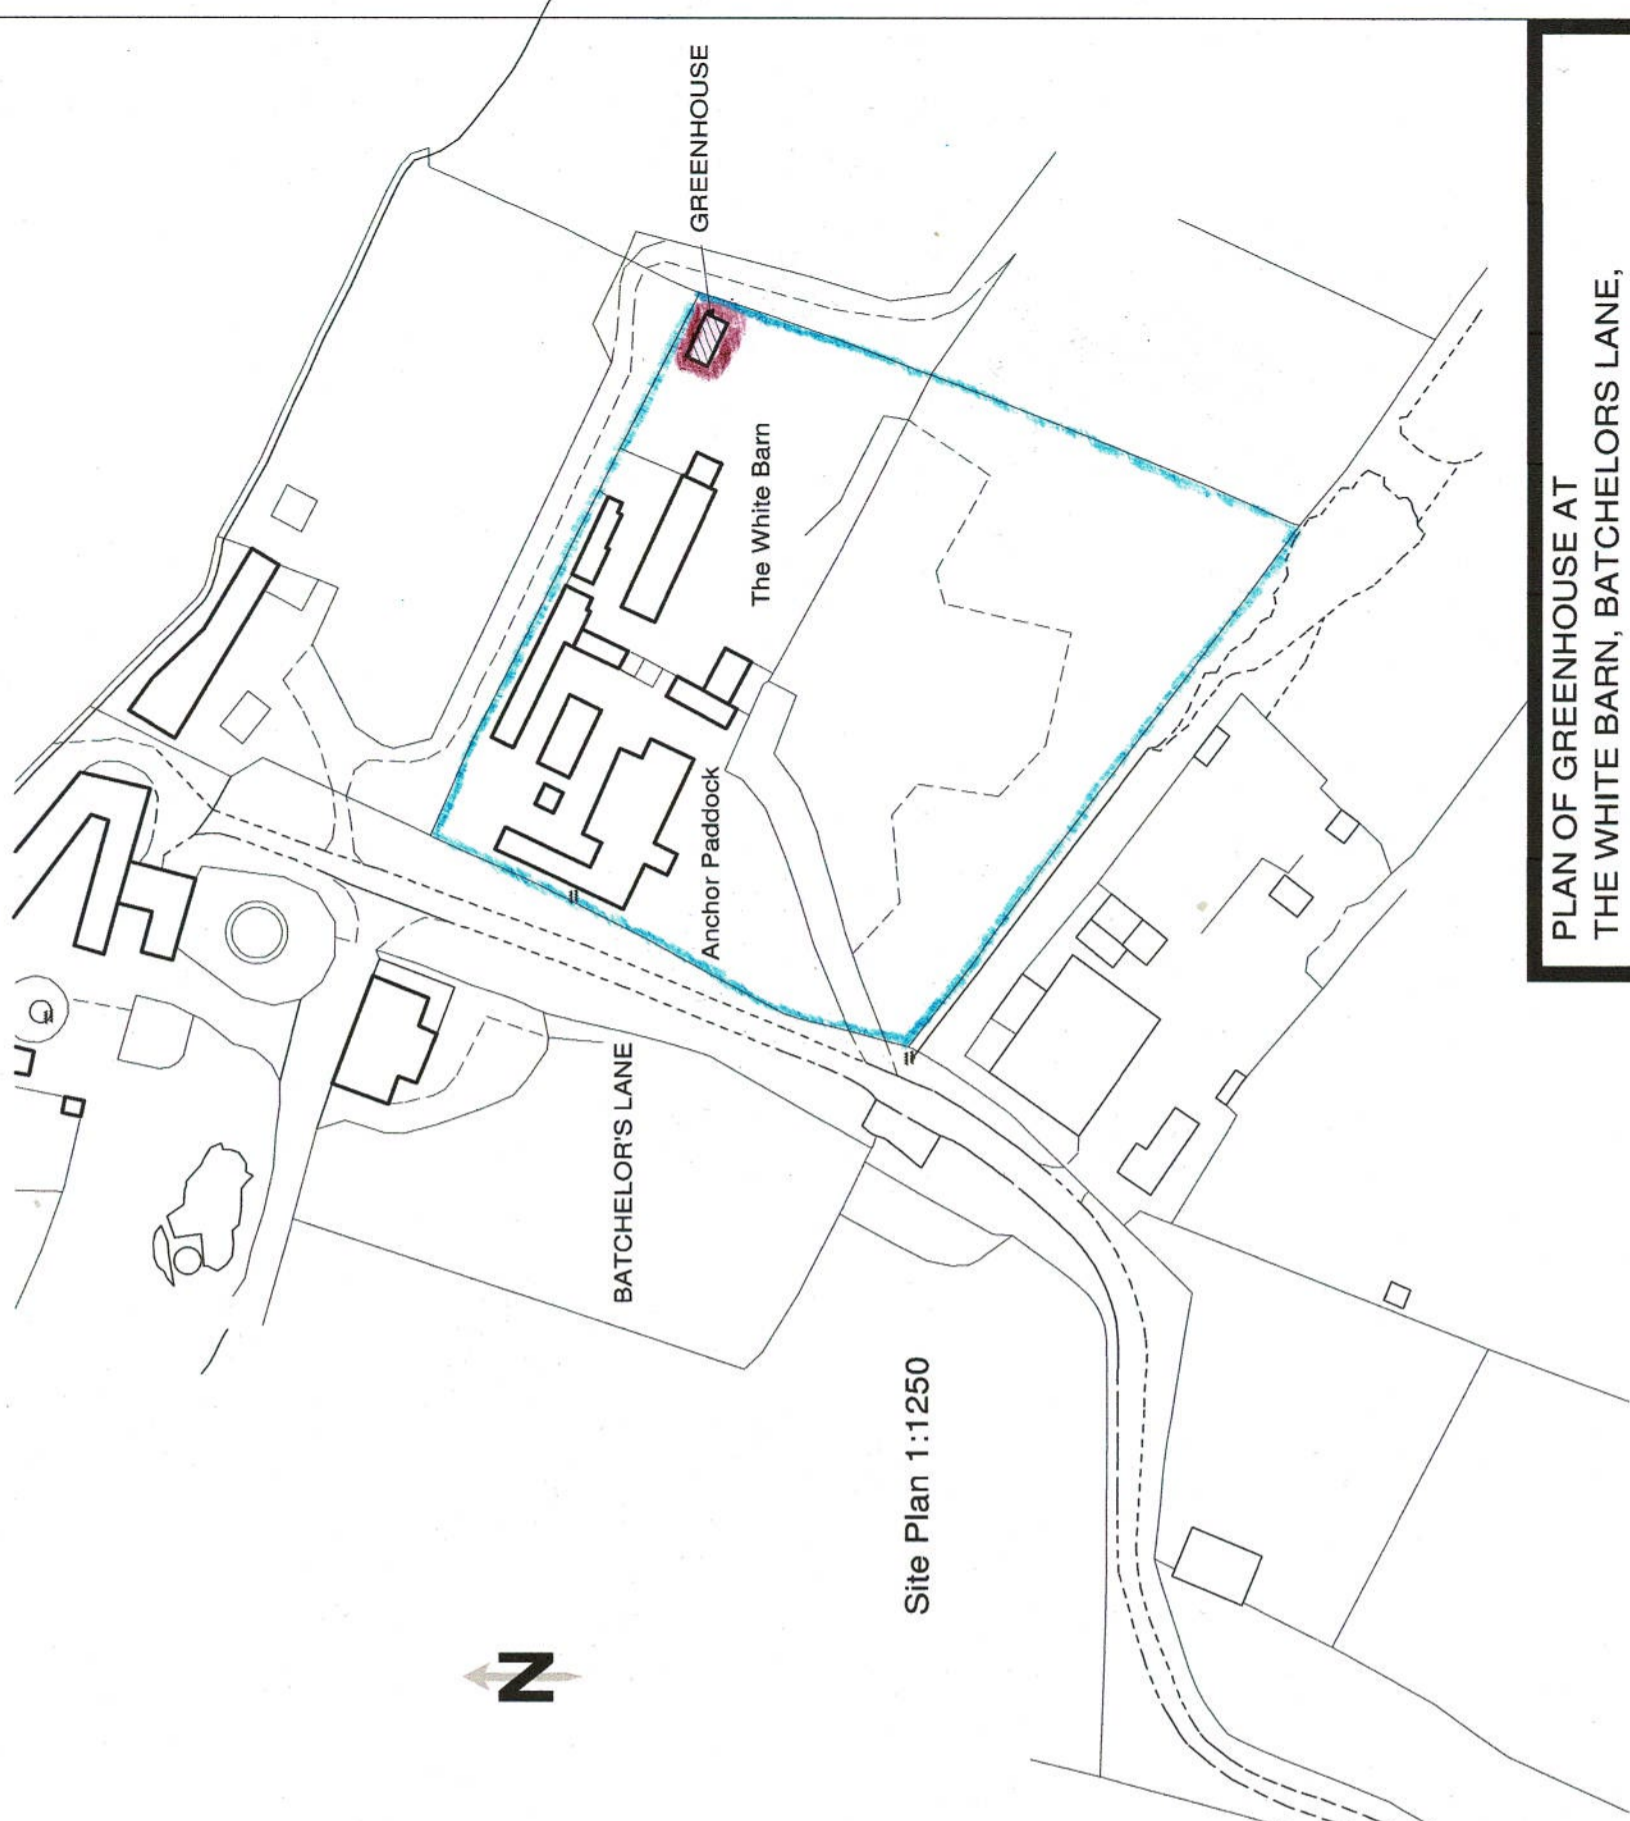

Site Plan 1:1250

# harriplan

**CORPORATE BUILDING ENGINEERS**  
 23-25 ABBOTT ROAD, BOURNEMOUTH  
 BH9 1EU. TEL. 01202 549 590. FAX. 01202 522901  
 E. Mail: jon@harriplan.com JON HARRISON M.C.A.B.E.





**PLAN OF GREENHOUSE AT  
 THE WHITE BARN, BATCHELORS LANE,  
 HOLTWOOD, NR. WIMBORNE, DORSET.**

**SITE & LOCATION PLANS**

**GREENHOUSE**


DRAWN BY:	J.G.H.
DRAWING NO:	4419-BE(4)A
DATE:	FEBRUARY 2024
SCALE:	AS SHOWN

AS EXISTING:-

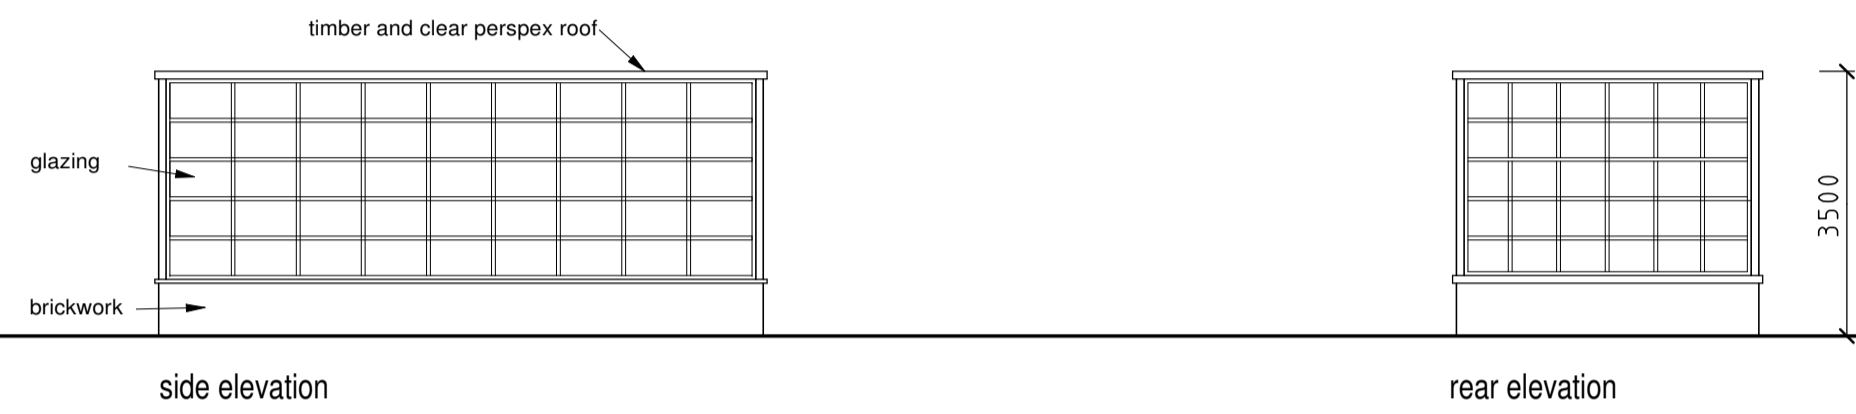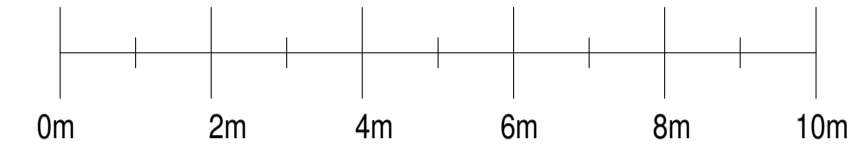


side elevation

rear elevation

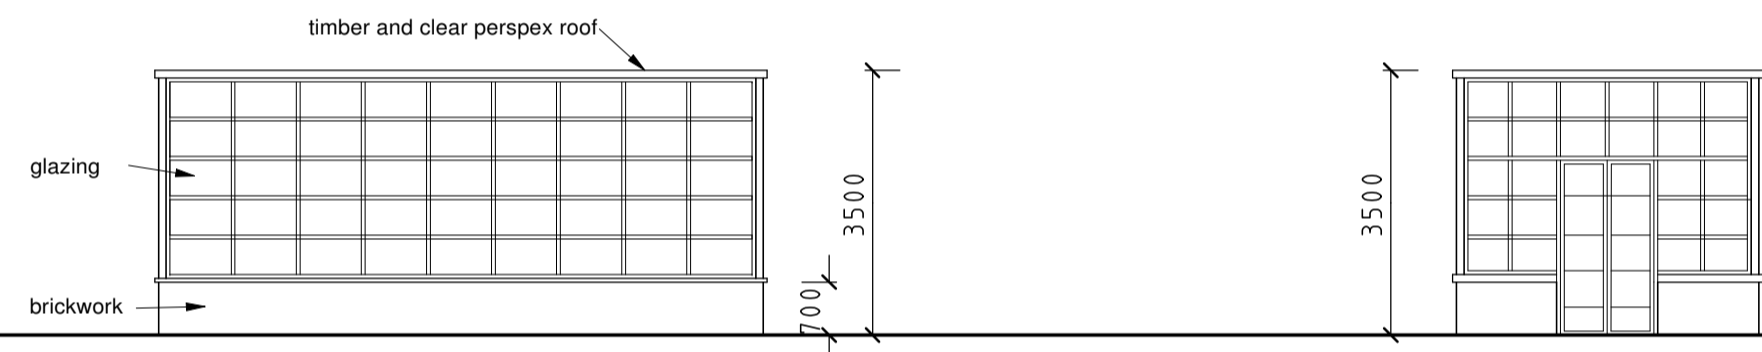


side elevation

front elevation


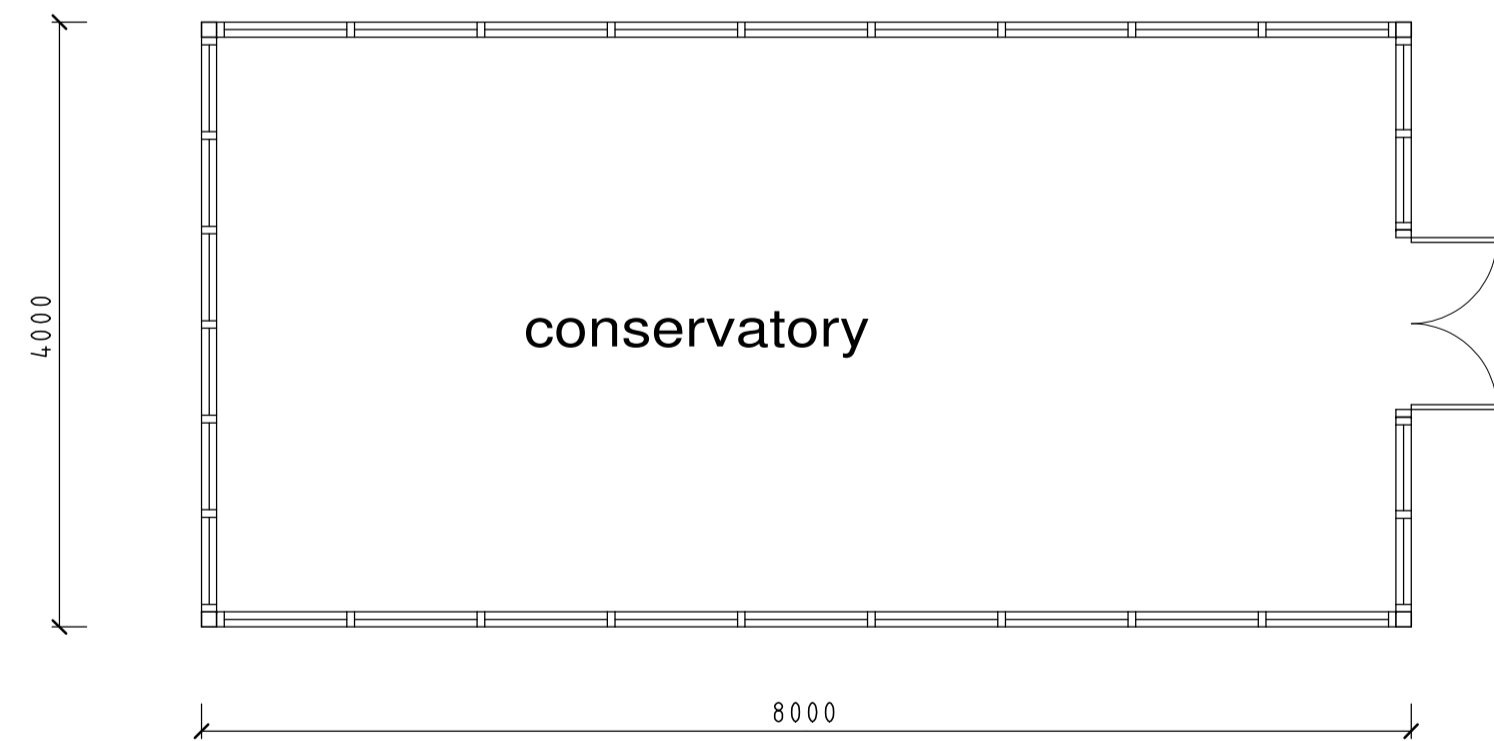


conservatory

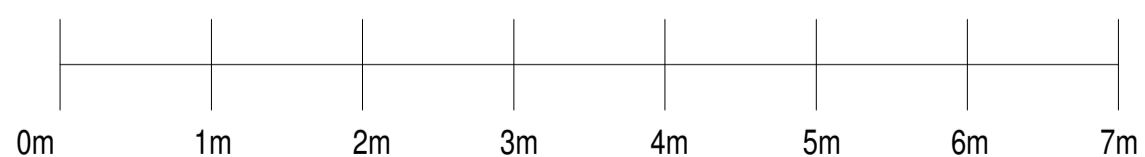


1:50 scale bar at A1

AS BUILT:-

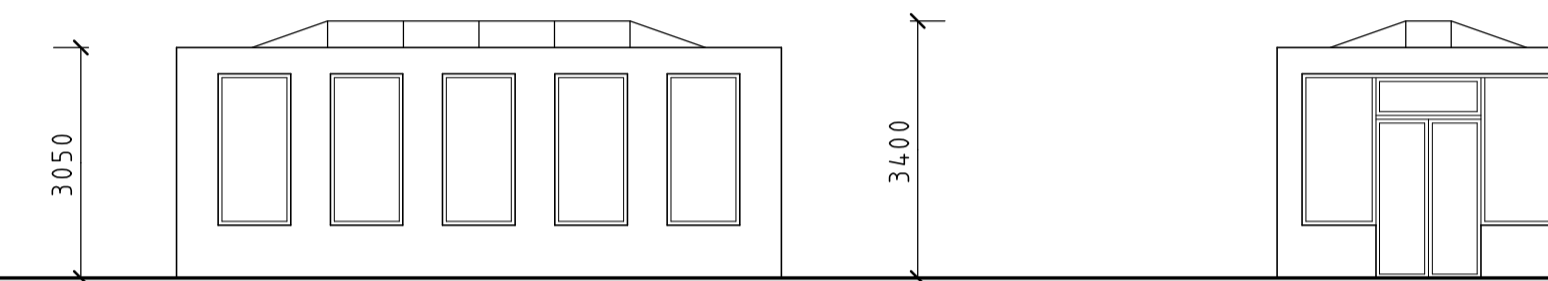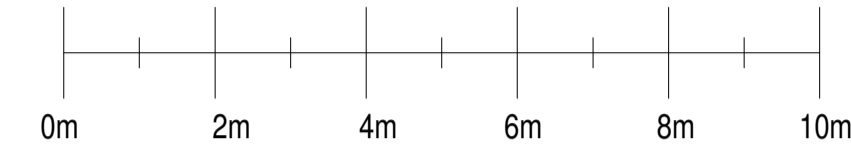


side elevation

rear elevation

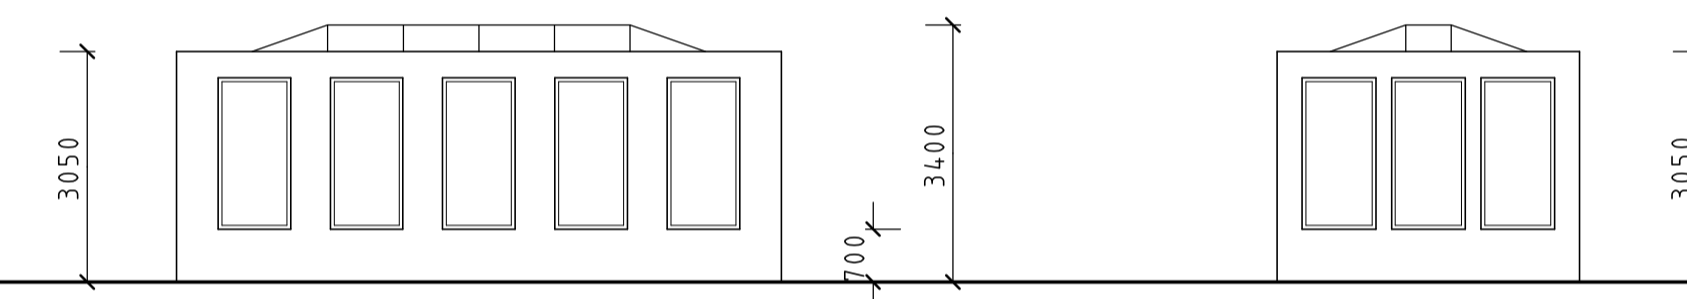

side elevation

front elevation

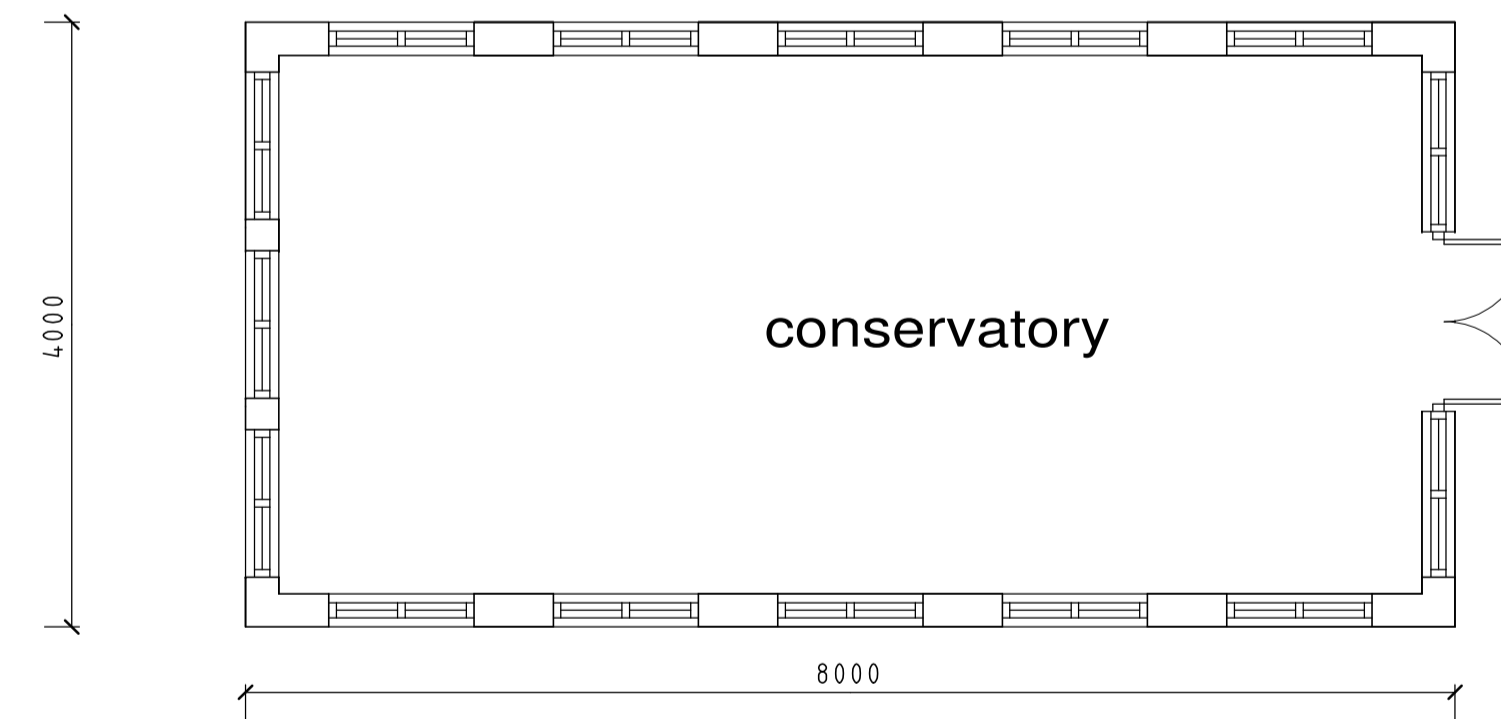

conservatory

PLAN OF:  
 GREENHOUSE AT  
 WHITE BARN,  
 BATCHELORS LANE,  
 HOLTWOOD, Nr. WIMBORNE, DORSET

DRAWN BY:	J. G. H.
DRAWING NO:	4 4 1 9-BE(4)
DATE:	JANUARY 2024
SCALE:	1:50 & 1:100

**NOTE:**

1. WORK TO FIGURED DIMENSIONS ONLY. DO NOT SCALE FROM DRAWINGS. SPECIFIC DIMENSIONS AVAILABLE ON REQUEST.
2. NO THIRD PARTY LIABILITY IS GIVEN. SALE OF PROPERTY DOES NOT TRANSFER RIGHTS OF USE. AVAILABLE ON AGREEMENT.
3. COPYRIGHT EXISTS ON ALL DRAWINGS. NO REPRODUCTION IN ANY FORM IS PERMITTED WITHOUT PRIOR CONSENT.
4. ALL WORK COMMENCED PRIOR TO FORMAL BUILDING REGULATION AND / OR PLANNING APPROVAL IS ENTIRELY AT CONTRACTORS / CLIENT'S OWN RISK.
- 5.

**harriplan**  
 CHARTERED BUILDING ENGINEERS  
 25 ABBOTT ROAD, CHARMINSTER  
 BOURNEMOUTH BH9 1EU. TEL/FAX 01202 549 590  
 E-Mail: jon@harriplan.com      JON HARRISON M.C.A.B.E.

**cabe**  
 chartered  
 building engineer