

# Location Plan

Site Address: Anchor Paddock, Batchelors Lane, Holt, BH21 7DS

Date Produced: 09-Feb-2024


Scale: 1:1250 @A4



Planning Portal Reference: PP-12796770v1



prior to works:

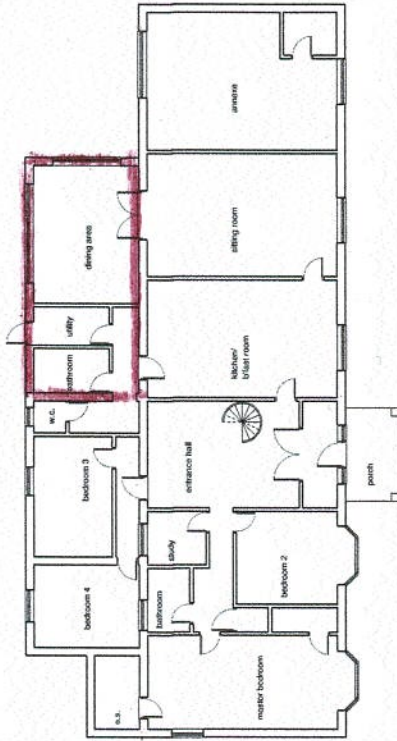

as built:




ground floor



1:100 scale bar at A1

first floor:

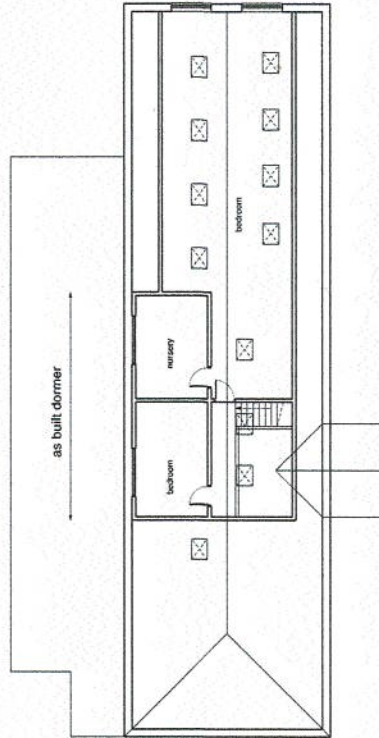

PLAN OF:  
 ALTERATIONS TO ANCHOR PADDOCK,  
 BACHELORS LANE,  
 HOLT, Nr. WIMBORNE DORSET  
 (as built alterations: floor plans)




**harriman**  
 CHARTERED BUILDING ENGINEERS  
 25 ABBOTT ROAD, CHARMINGFORD  
 BOURNEMOUTH BH9 7EJ. TEL/FAX 01329 448 598  
 E. Matt.Jay@harriman.com JAYWIMBORNE@GMAIL.COM


NOTE:  
 1. THIS DRAWING IS FOR INFORMATION ONLY. IT DOES NOT SCALE FROM DRAWINGS. PROTECT DIMENSIONS HAVE BEEN CHECKED.  
 2. NO THIRD PARTY LIABILITY IS GIVEN. SALE OF PROPERTY DOES NOT TRANSFER LIABILITY OF USE. AVAILABLE ON AGREEMENT.  
 3. ALL WORKS COMPLETED SUBJECT TO EXISTING BUILDING REGULATIONS AND OBTAINING APPROVALS WHERE NECESSARY.  
 4. CONTRACTORS - CLIENT'S OWN RISK.

DRAWN BY: J.G.H.  
 DRAWING NO: 4419A(3C)  
 DATE: FEBRUARY 2024  
 SCALE: 1:100

16  
15  
14  
13  
12  
11  
10  
9  
8

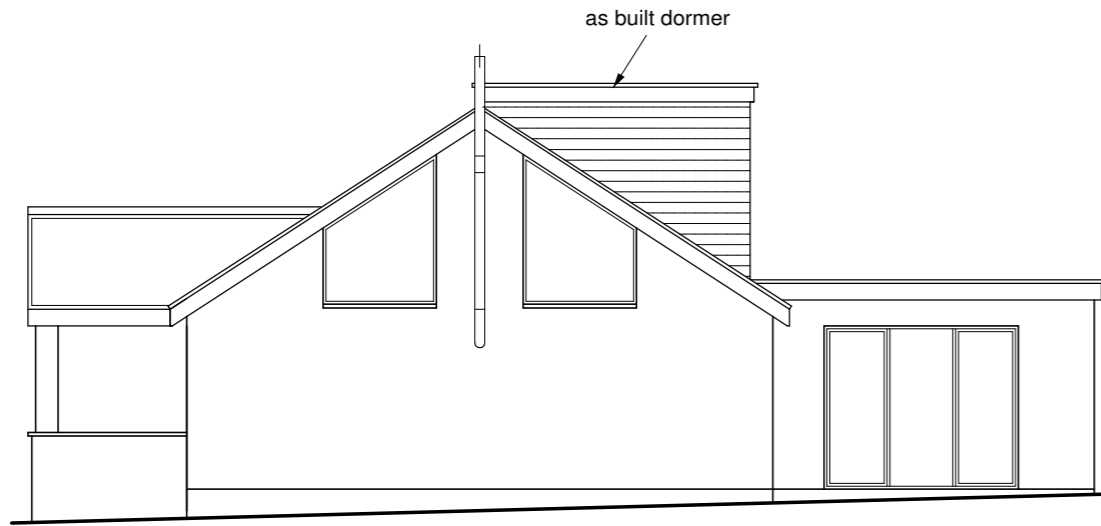


side elevation

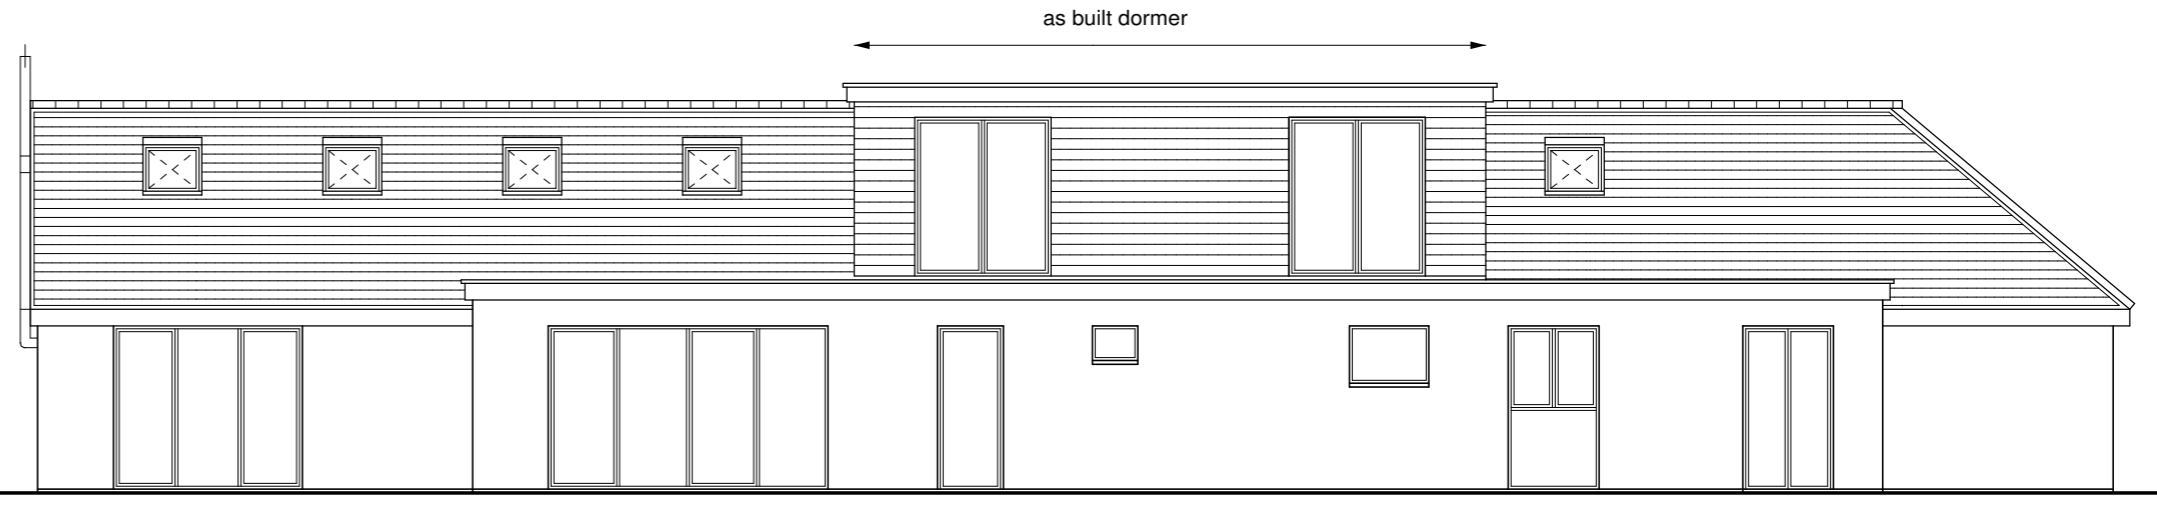


rear elevation


16  
15  
14  
13  
12  
11  
10  
9  
8

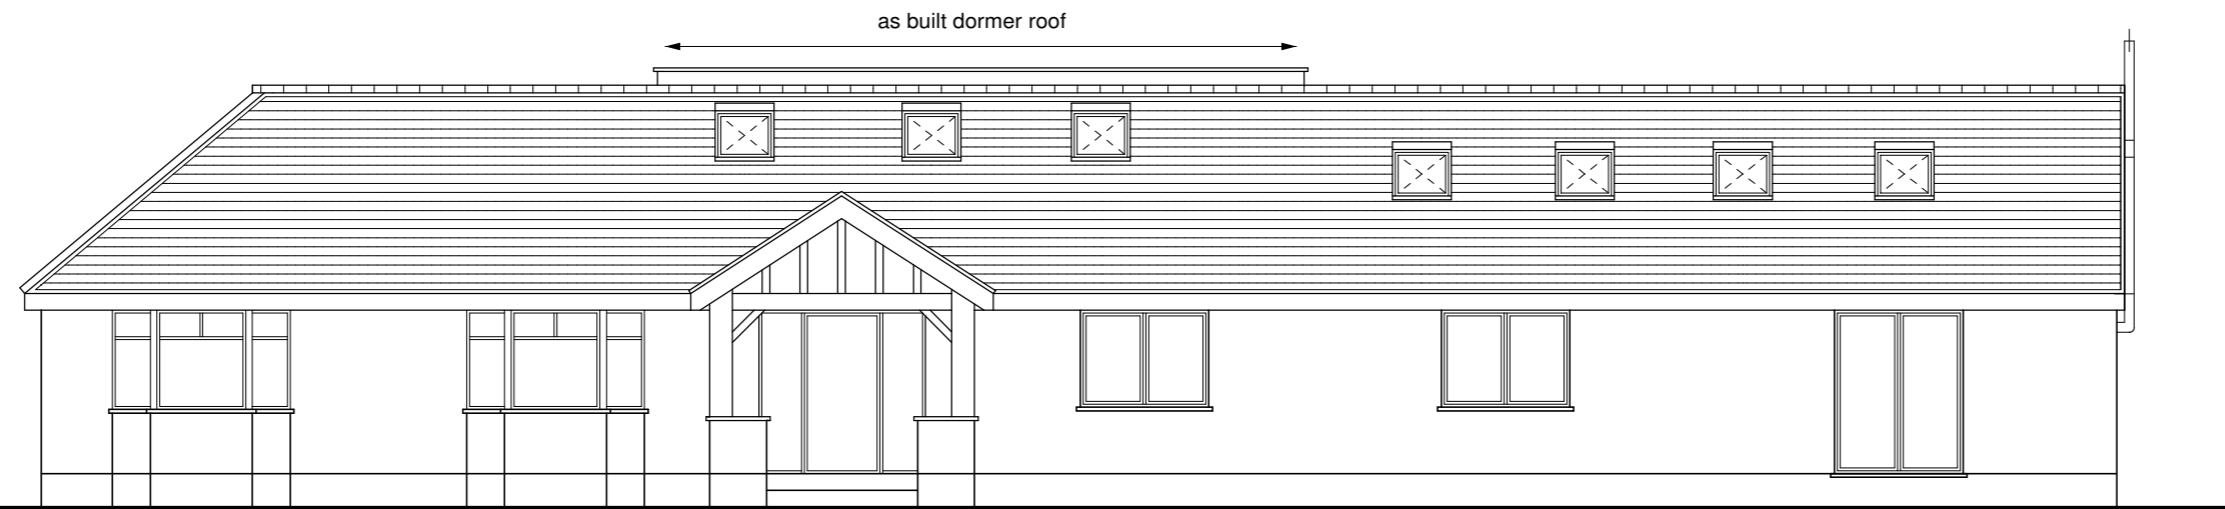

front elevation

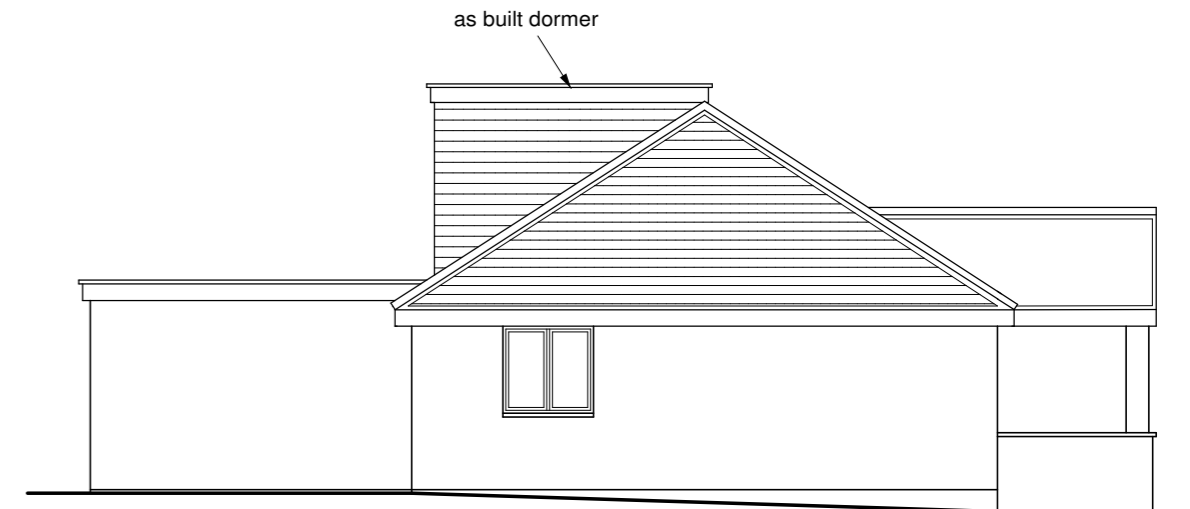

side elevation

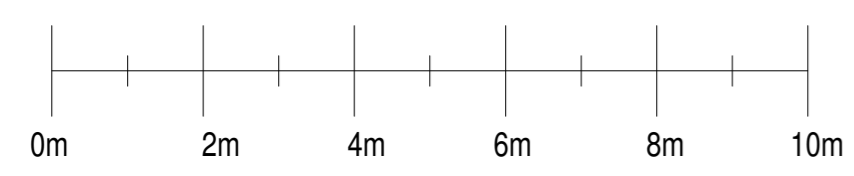

1:100 scale bar at A2

**harriplan**

CORPORATE BUILDING ENGINEERS  
23 - 25 ABBOTT ROAD, BOURNEMOUTH  
BH9 1EU. TEL. 01202 549590. FAX. 01202 522901

E. Mail: jon@harriplan.com

JON HARRISON M.C.A.B.E.



**NOTE:**

1. WORK TO FIGURED DIMENSIONS ONLY. DO NOT SCALE FROM DRAWINGS. SPECIFIC DIMENSIONS AVAILABLE ON REQUEST.
2. NO THIRD PARTY LIABILITY IS GIVEN. SALE OF PROPERTY DOES NOT TRANSFER RIGHTS OF USE: AVAILABLE ON AGREEMENT.
3. COPYRIGHT EXISTS ON ALL DRAWINGS. NO REPRODUCTION IN ANY FORM IS PERMITTED WITHOUT PRIOR CONSENT.
4. ALL WORK COMMENCED PRIOR TO FORMAL BUILDING REGULATION AND / OR PLANNING APPROVAL IS ENTIRELY AT CONTRACTOR'S / CLIENT'S OWN RISK.
5. CLIENTS TO BE AWARE OF THEIR RESPONSIBILITIES/LIABILITIES UNDER HEALTH & SAFETY LEGISLATION

DRAWN BY:	J.G.H.
DRAWING NO:	4419:A 2
DATE:	AUGUST 2022
SCALE:	1:100

PLAN OF:  
ALTERATIONS TO ANCHOR PADDOCK,  
BACHELORS LANE,  
HOLT, Nr. WIMBORNE DORSET  
  
(as built alterations)