
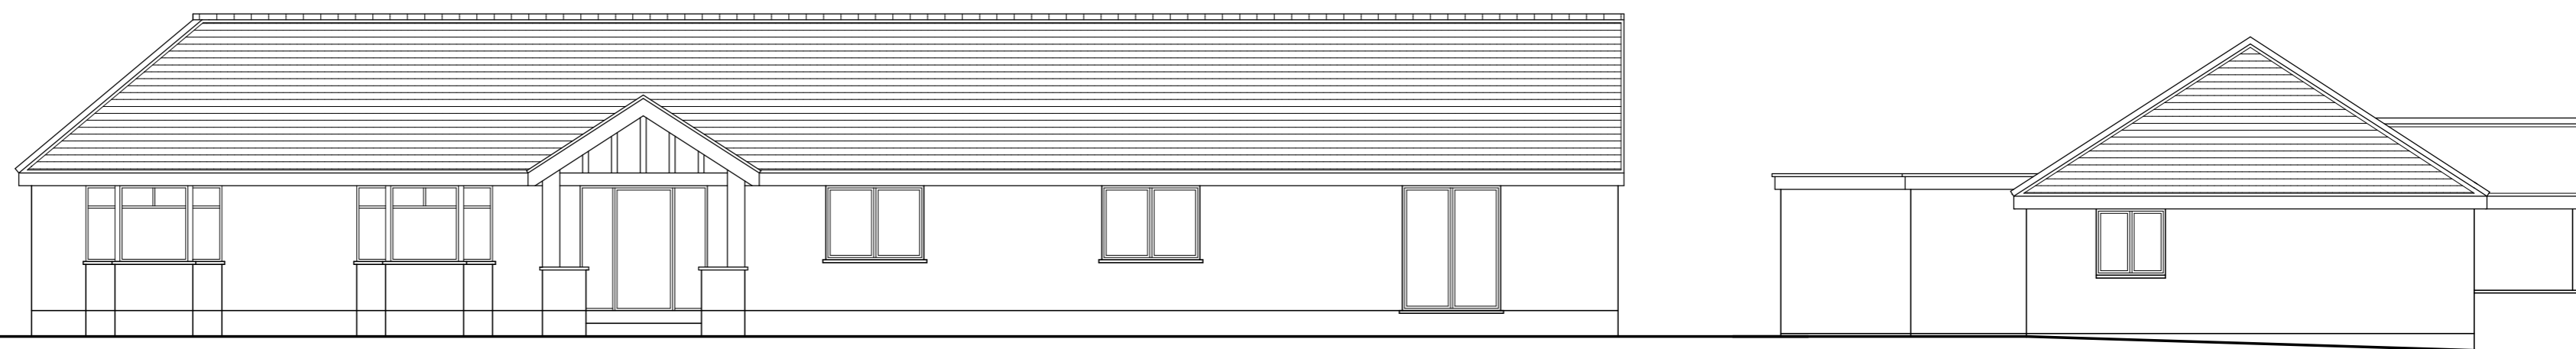



side elevation

rear elevation

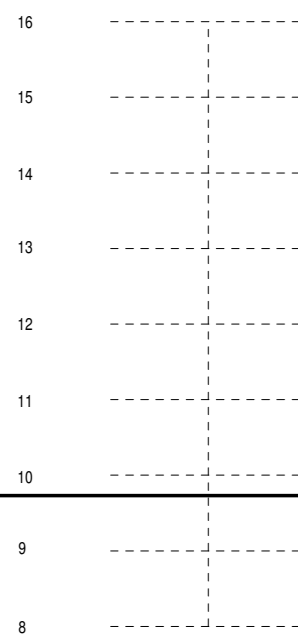

front elevation

side elevation

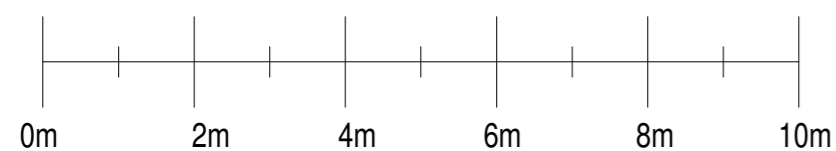

1:100 scale bar at A2

h a r r i p l a n

CORPORATE BUILDING ENGINEERS
23-25 ABBOTT ROAD, BOURNEMOUTH
BH9 1EU. TEL. 01202 549590. FAX. 01202 522901

E-Mail: jon@harriplan.com

JON HARRISON M.C.A.B.E.



NOTE:


1. WORK TO FIGURED DIMENSIONS ONLY. DO NOT SCALE FROM DRAWINGS. SPECIFIC DIMENSIONS AVAILABLE ON REQUEST.
2. NO THIRD PARTY LIABILITY IS GIVEN. SALE OF PROPERTY DOES NOT TRANSFER RIGHTS OF USE: AVAILABLE ON AGREEMENT.
3. COPYRIGHT EXISTS ON ALL DRAWINGS. NO REPRODUCTION IN ANY FORM IS PERMITTED WITHOUT PRIOR CONSENT.
4. ALL WORK COMMENCED PRIOR TO FORMAL BUILDING REGULATION AND / OR PLANNING APPROVAL IS ENTIRELY AT CONTRACTOR'S / CLIENT'S OWN RISK.
5. CLIENTS TO BE AWARE OF THEIR RESPONSIBILITIES/LIABILITIES UNDER HEALTH & SAFETY LEGISLATION

DRAWN BY:	J.G.H.
DRAWING NO:	4419:A1(A)
DATE:	AUGUST 2022
SCALE:	1:100

PLAN OF:
ALTERATIONS TO ANCHOR Paddock,
BACHELORS LANE,
HOLT, Nr. WIMBORNE DORSET

(dwelling prior to alterations)


prior to works:

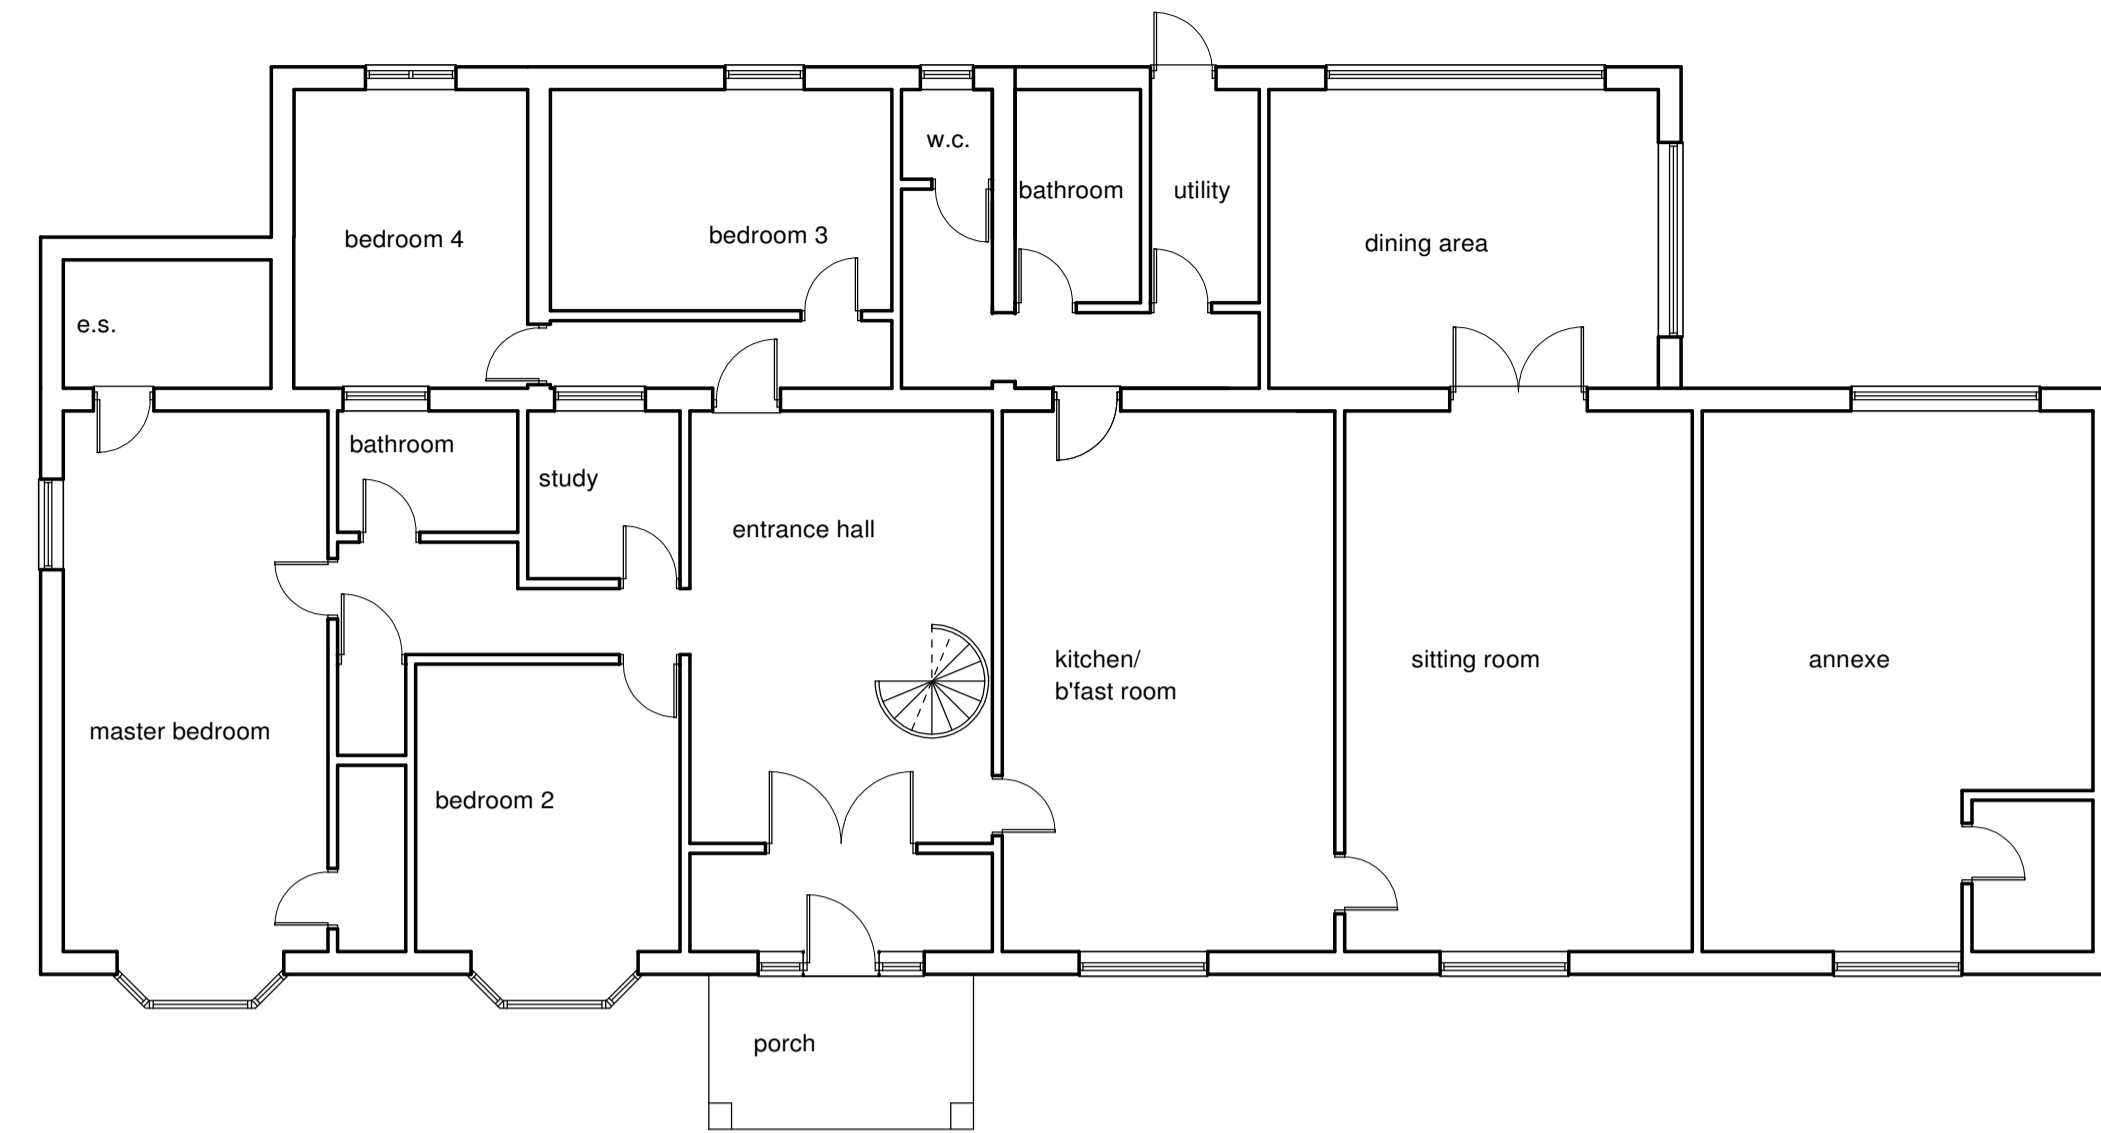


as built:



ground floor

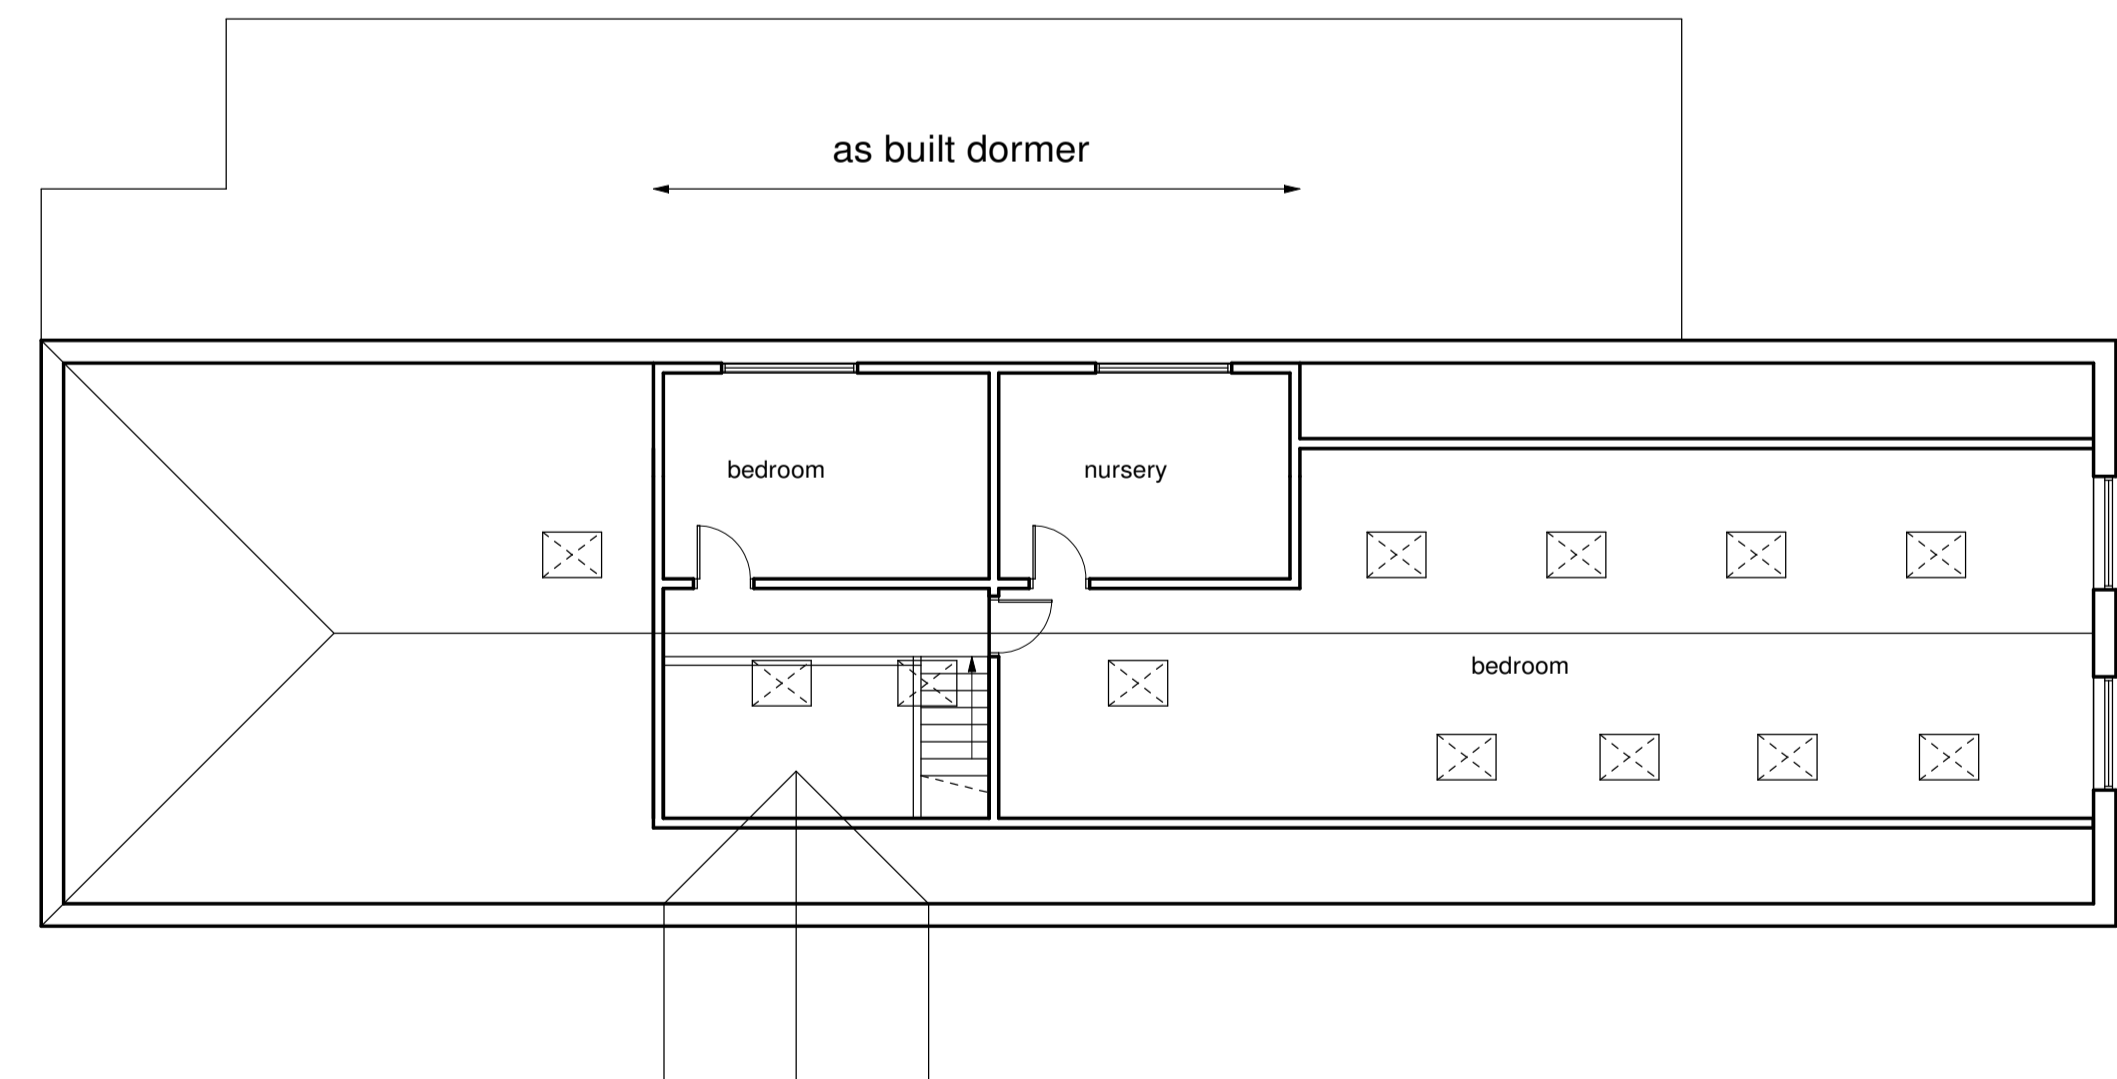

first floor:

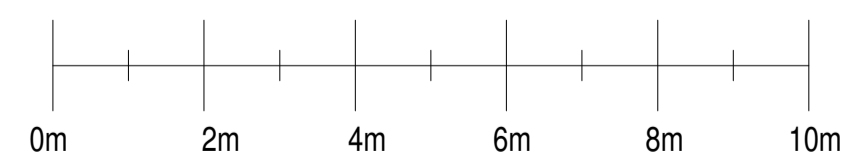

1:100 scale bar at A1




PLAN OF:
ALTERATIONS TO ANCHOR PADDOCK,
BACHELORS LANE,
HOLT, Nr. WIMBORNE DORSET

(as built alterations: floor plans)

DRAWN BY:	J.G.h.
DRAWING NO:	4419:A(3C)
DATE:	FEBRUARY 2024
SCALE:	1:100

NOTE:
1. WORK TO FIGURED DIMENSIONS ONLY. DO NOT SCALE FROM DRAWINGS. SPECIFIC DIMENSIONS AVAILABLE ON REQUEST.
2. NO THIRD PARTY LIABILITY IS GIVEN. SALE OF PROPERTY DOES NOT TRANSFER RIGHTS OF USE. AVAILABLE ON AGREEMENT.
3. COPYRIGHT EXISTS ON ALL DRAWINGS. NO REPRODUCTION IN ANY FORM IS PERMITTED WITHOUT PRIOR CONSENT.
4. ALL WORK COMMENCED PRIOR TO FORMAL BUILDING REGULATION AND / OR PLANNING APPROVAL IS ENTIRELY AT CONTRACTOR'S / CLIENT'S OWN RISK.
5.

harriplan
CHARTERED BUILDING ENGINEERS
25 ABBOTT ROAD, CHARMINSTER
BOURNEMOUTH BH9 1EU. TEL/FAX 01202 549 590
E-Mail: jon@harriplan.com JON HARRISON M.C.A.B.E.

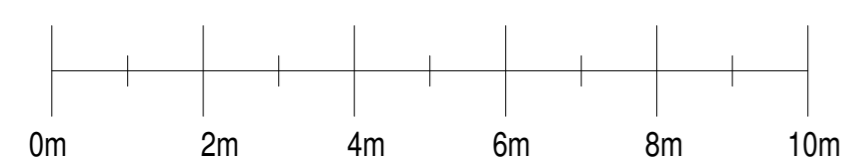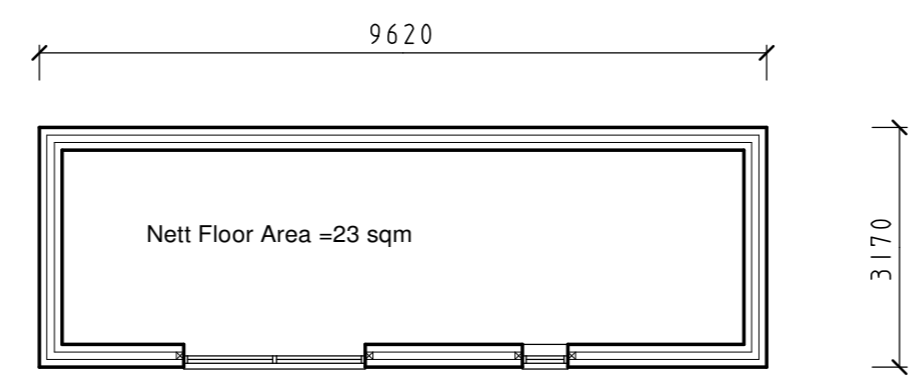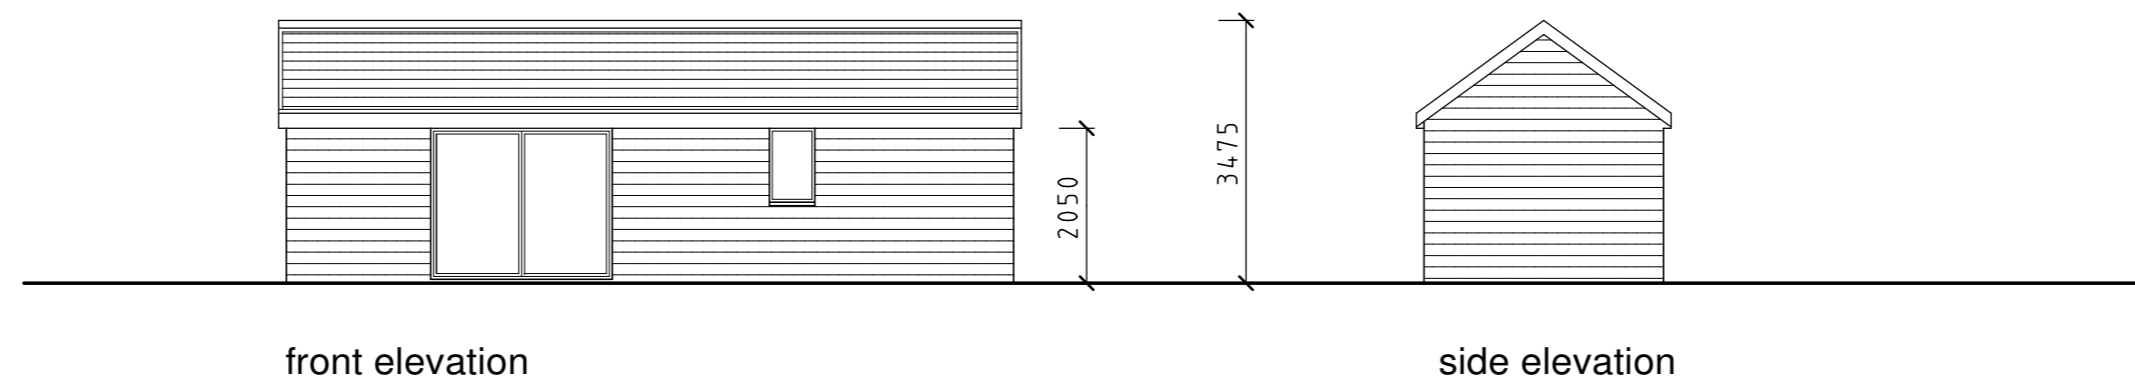


1:100 scale bar at A2

front elevation

side elevation

plan

h a r r i p l a n	
CORPORATE BUILDING ENGINEERS 23 - 25 ABBOTT ROAD, BOURNEMOUTH BH9 1EU. TEL. 01202 549590. FAX. 01202 522901	
E. Mail: jon@harriplan.com	JON HARRISON M.C.A.B.E.

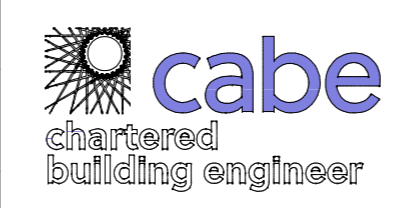


PLAN OF:
 ATTACHED BUILDING AT
 ANCHOR PADDOCK,
 BATCHELORS LANE,
 HOLTWOOD, Nr WIMBORNE.


- NOTE:**
1. WORK TO FIGURED DIMENSIONS ONLY. DO NOT SCALE FROM DRAWINGS. SPECIFIC DIMENSIONS AVAILABLE ON REQUEST.
 2. NO THIRD PARTY LIABILITY IS GIVEN. SALE OF PROPERTY DOES NOT TRANSFER RIGHTS OF USE: AVAILABLE ON AGREEMENT.
 3. COPYRIGHT EXISTS ON ALL DRAWINGS. NO REPRODUCTION IN ANY FORM IS PERMITTED WITHOUT PRIOR CONSENT.
 4. ALL WORK COMMENCED PRIOR TO FORMAL BUILDING REGULATION AND / OR PLANNING APPROVAL IS ENTIRELY AT CONTRACTOR'S / CLIENT'S OWN RISK.
 5. CLIENTS TO BE AWARE OF THEIR RESPONSIBILITIES/LIABILITIES UNDER HEALTH & SAFETY LEGISLATION

DRAWN BY:	J. G. H.
DRAWING NO:	4419:A(4)A
DATE:	JANUARY 2024
SCALE:	1:100

16
15
14
13
12
11
10
9
8

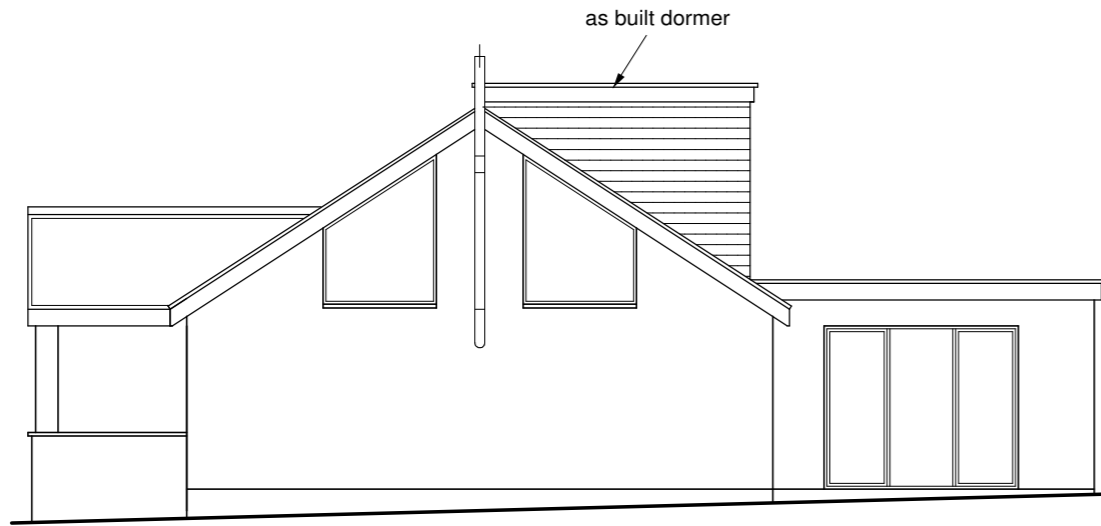


side elevation

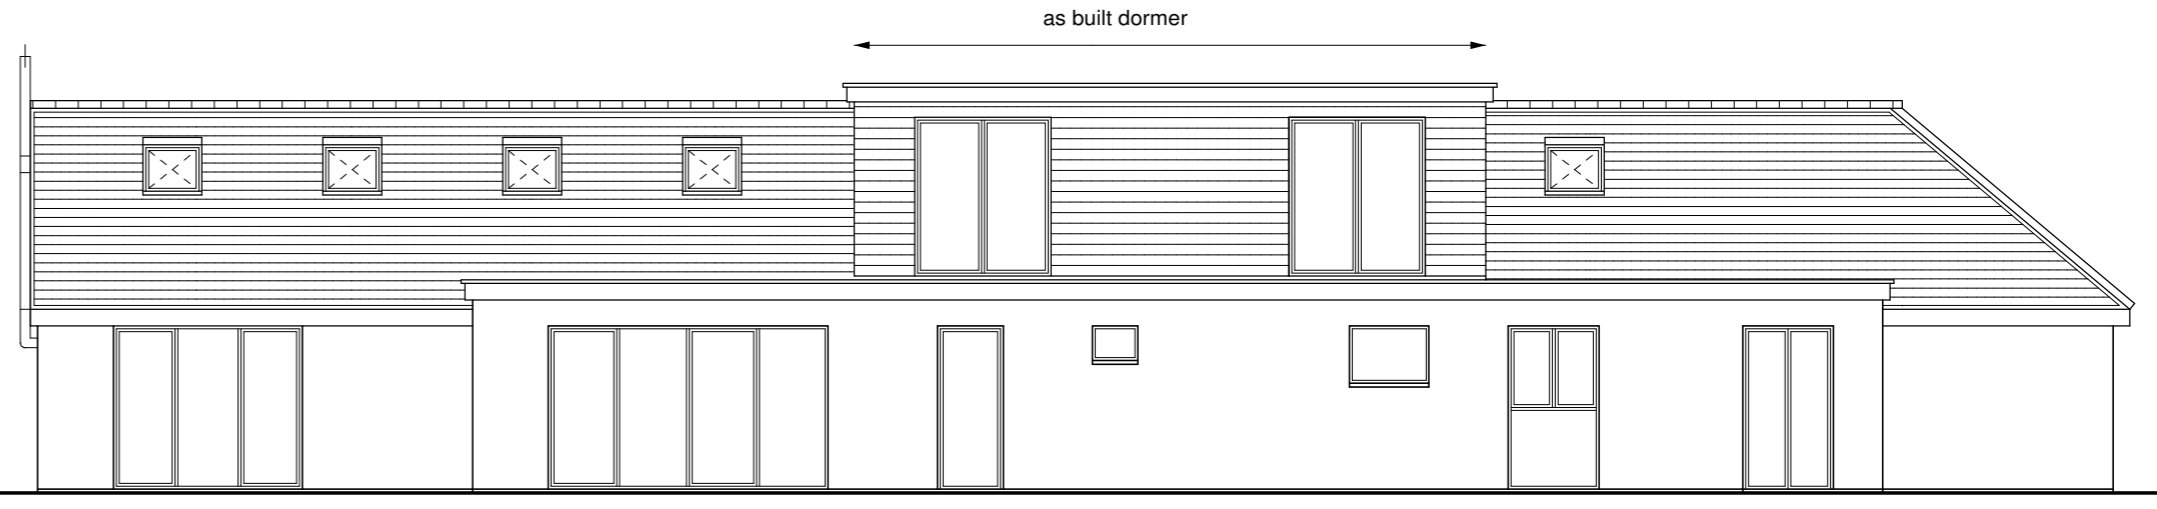


rear elevation


16
15
14
13
12
11
10
9
8

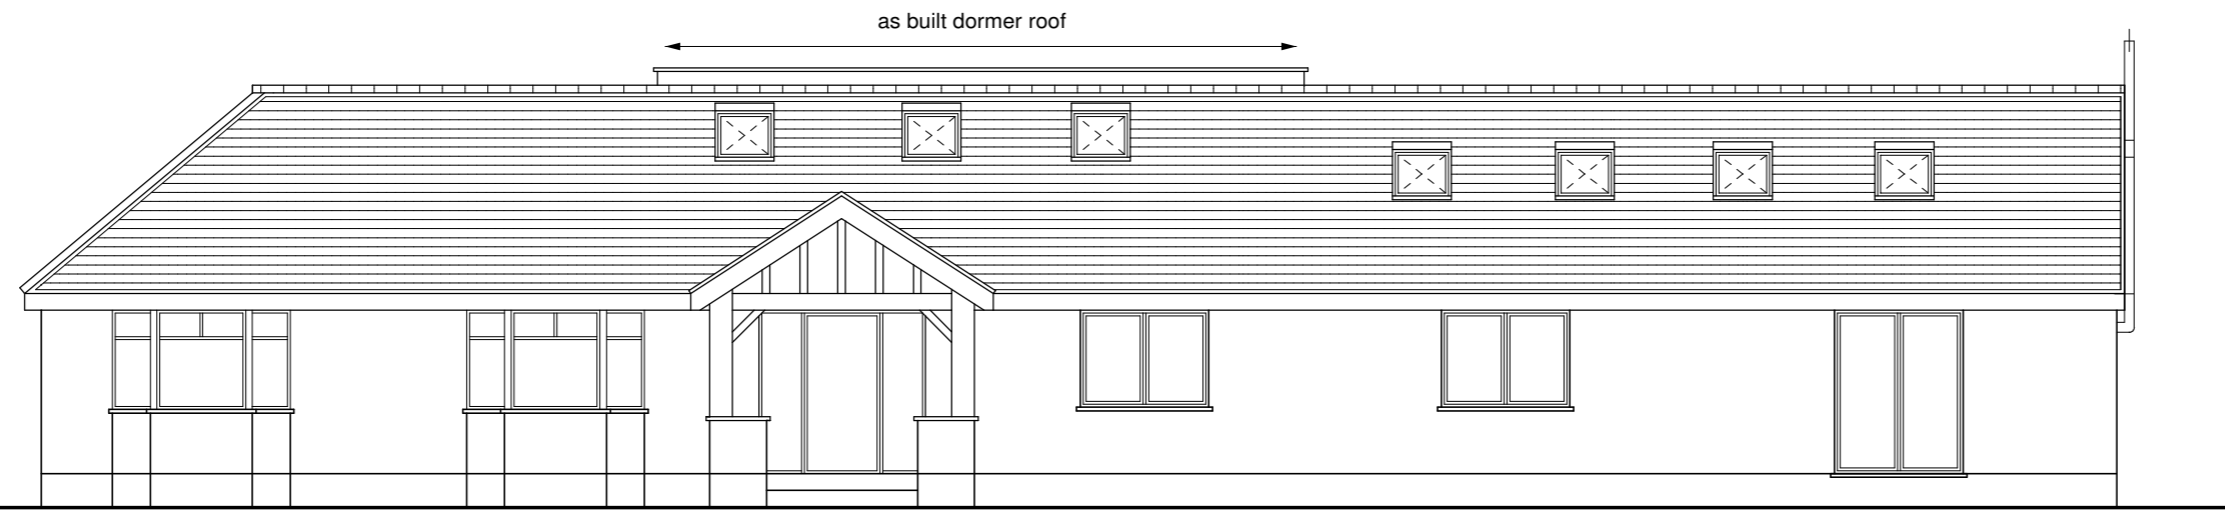

front elevation

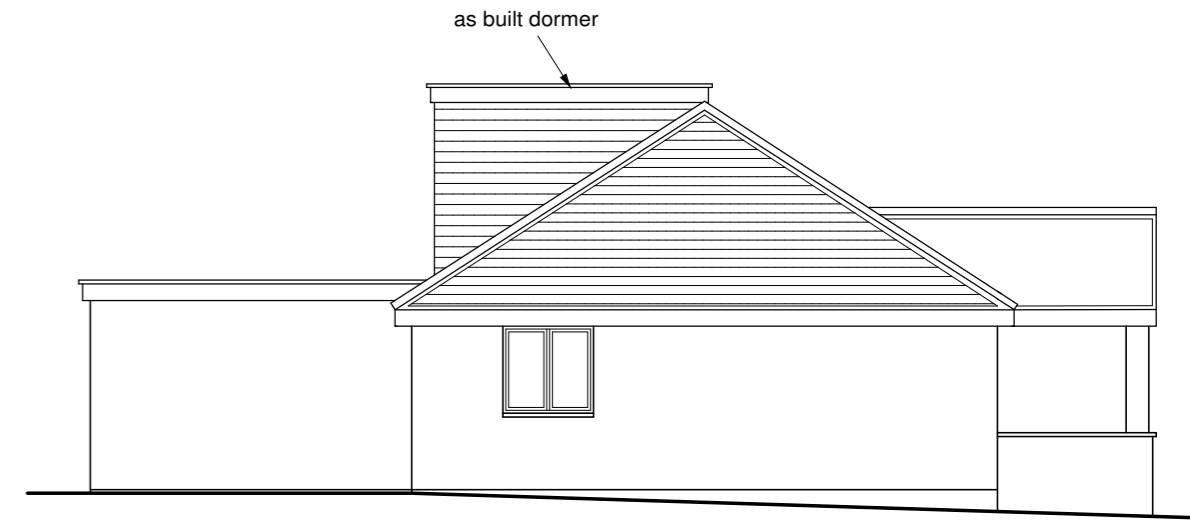

side elevation

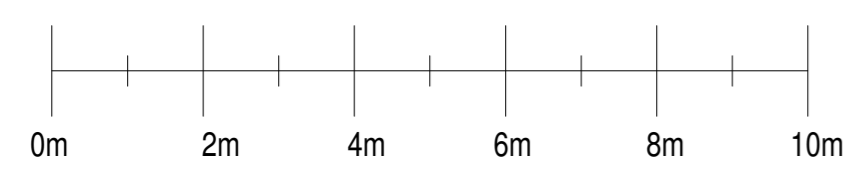

1:100 scale bar at A2

harriplan

CORPORATE BUILDING ENGINEERS
23 - 25 ABBOTT ROAD, BOURNEMOUTH
BH9 1EU. TEL. 01202 549 590. FAX. 01202 522901

E. Mail: jon@harriplan.com

JON HARRISON M.C.A.B.E.



DRAWN BY:	J.G.H.
DRAWING NO:	4419:A 2
DATE:	AUGUST 2022
SCALE:	1:100

NOTE:


1. WORK TO FIGURED DIMENSIONS ONLY. DO NOT SCALE FROM DRAWINGS. SPECIFIC DIMENSIONS AVAILABLE ON REQUEST.
2. NO THIRD PARTY LIABILITY IS GIVEN. SALE OF PROPERTY DOES NOT TRANSFER RIGHTS OF USE: AVAILABLE ON AGREEMENT.
3. COPYRIGHT EXISTS ON ALL DRAWINGS. NO REPRODUCTION IN ANY FORM IS PERMITTED WITHOUT PRIOR CONSENT.
4. ALL WORK COMMENCED PRIOR TO FORMAL BUILDING REGULATION AND / OR PLANNING APPROVAL IS ENTIRELY AT CONTRACTOR'S / CLIENT'S OWN RISK.
5. CLIENTS TO BE AWARE OF THEIR RESPONSIBILITIES/LIABILITIES UNDER HEALTH & SAFETY LEGISLATION

PLAN OF:
ALTERATIONS TO ANCHOR PADDOCK,
BACHELORS LANE,
HOLT, Nr. WIMBORNE DORSET


(as built alterations)




Site Plan 1:500

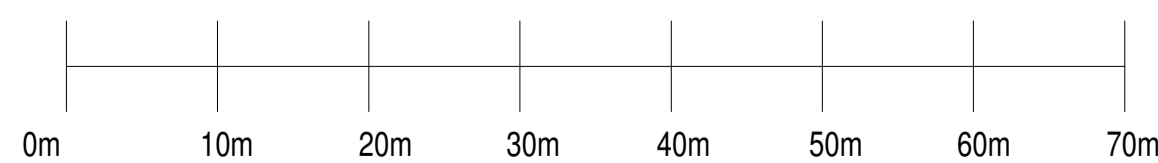

1:500 scale bar at A1

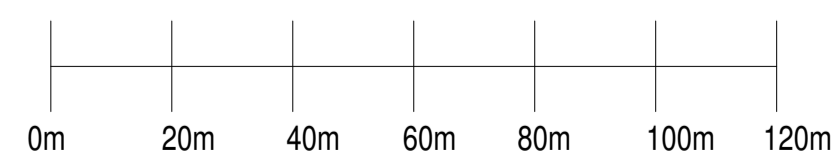

1:1250 scale bar at A1

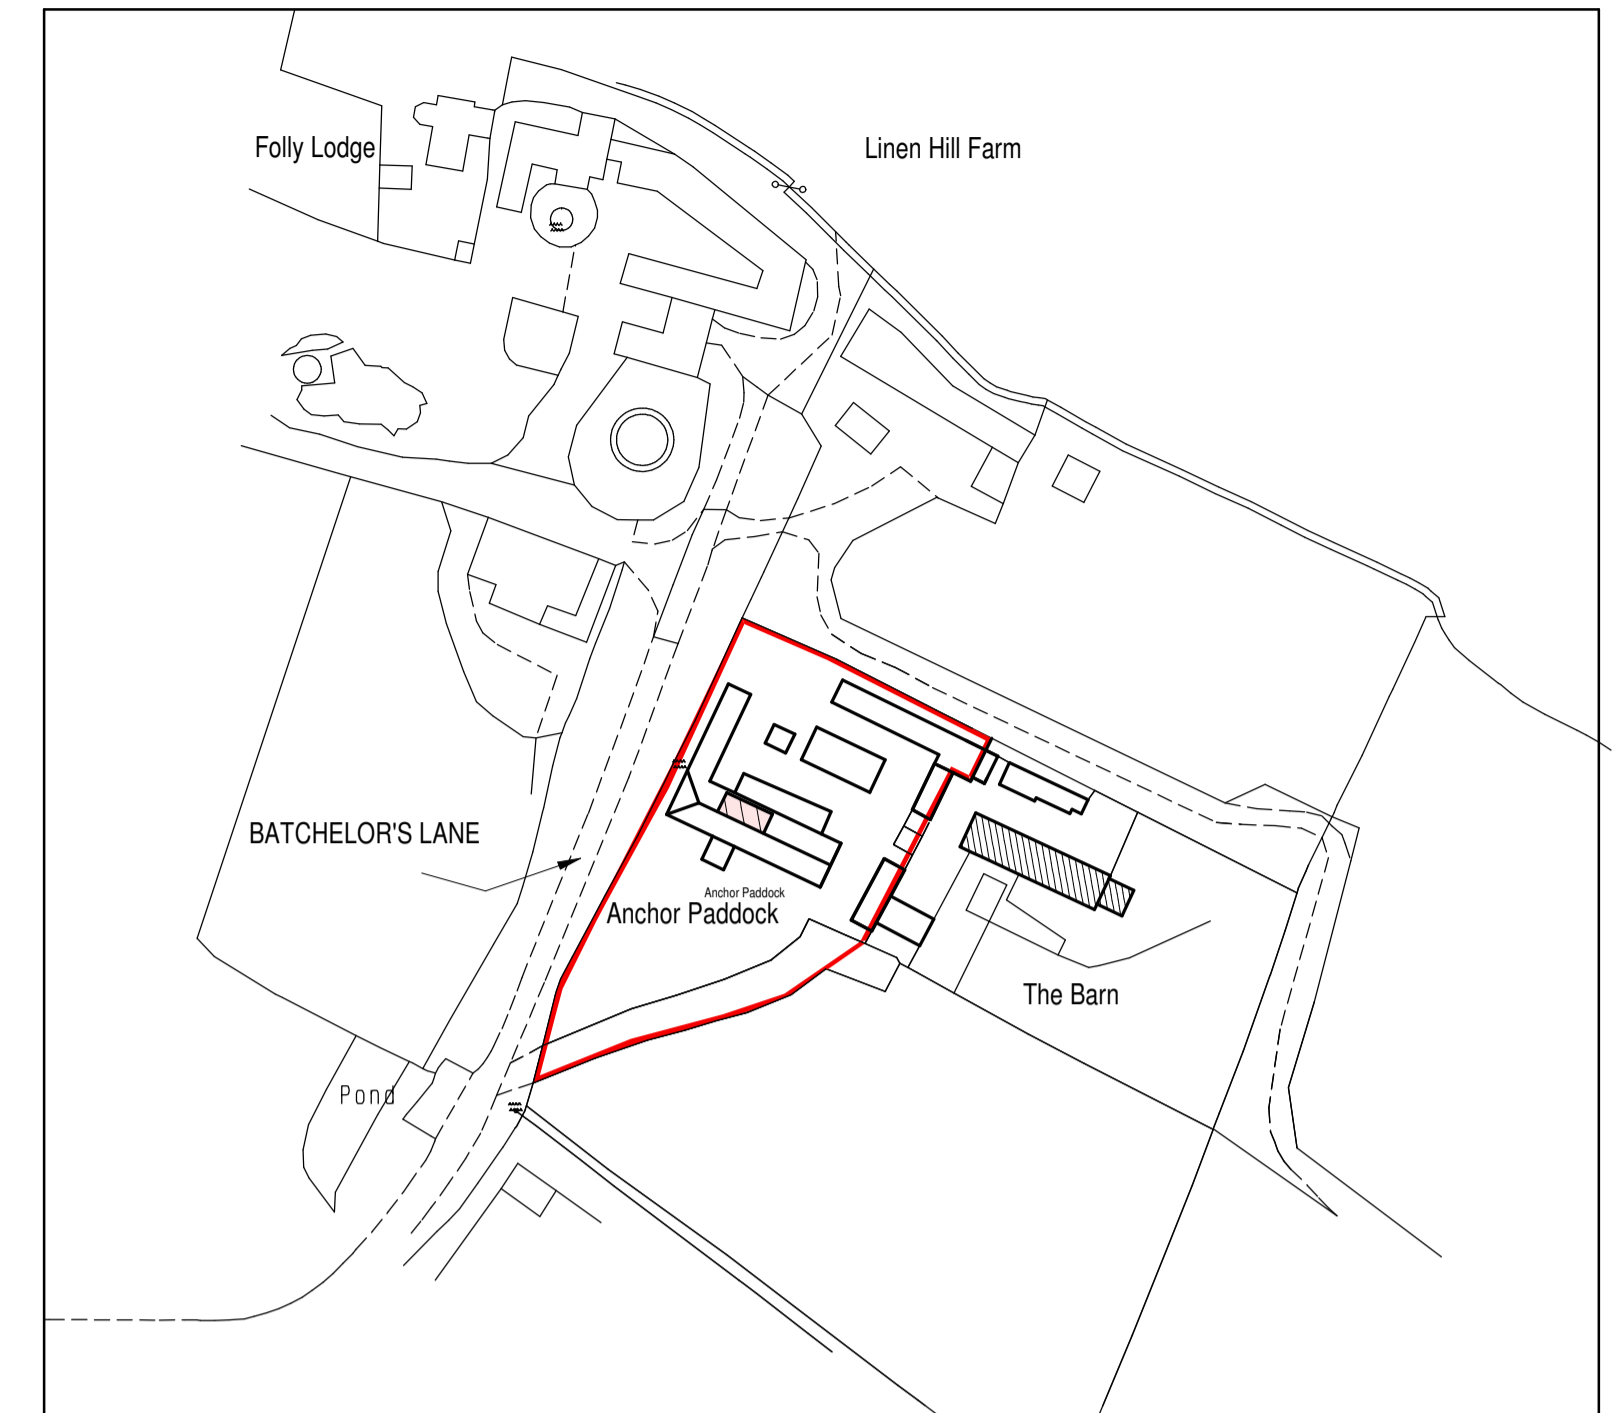

Ordnance Survey (c) Crown Copyright 2020. All rights reserved. Licence number 100022432

Location Plan 1:1250



PROPOSED ALTERATIONS TO BARN AT
ANCHOR PADDOCK, BATCHELORS LANE,
HOLTWOOD, Nr. WIMBORNE, DORSET.

SITE & LOCATION PLANS




(Planning: sheet 2 of 2)

DRAWN BY:	J.G.H.
DRAWING NO:	4419: A-(6)
DATE:	JANUARY 2024
SCALE:	1:500 & 1:1250

NOTE:
1. WORK TO FIGURED DIMENSIONS ONLY. DO NOT SCALE FROM DRAWINGS. SPECIFIC DIMENSIONS AVAILABLE ON REQUEST.
2. NO THIRD PARTY LIABILITY IS GIVEN. SALE OF PROPERTY DOES NOT TRANSFER RIGHTS OF USE. AVAILABLE ON AGREEMENT.
3. COPYRIGHT EXISTS ON ALL DRAWINGS. NO REPRODUCTION IN ANY FORM IS PERMITTED WITHOUT PRIOR CONSENT.
4. ALL WORK COMMENCED PRIOR TO FORMAL BUILDING REGULATION AND / OR PLANNING APPROVAL IS ENTIRELY AT CONTRACTOR'S / CLIENT'S OWN RISK.
5.

harriplan	
CHARTERED BUILDING ENGINEERS	
25 ABBOTT ROAD, CHARMINSTER	
BOURNEMOUTH BH9 1EU. TEL/FAX 01202 549 590	
E-Mail: jon@harriplan.com	JON HARRISON M.C.A.B.E.



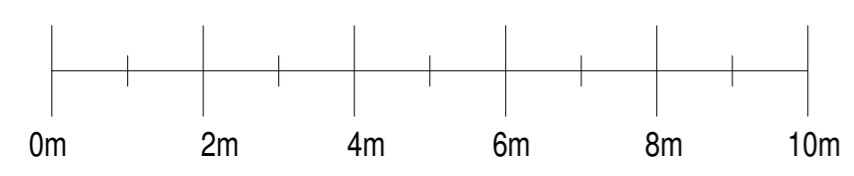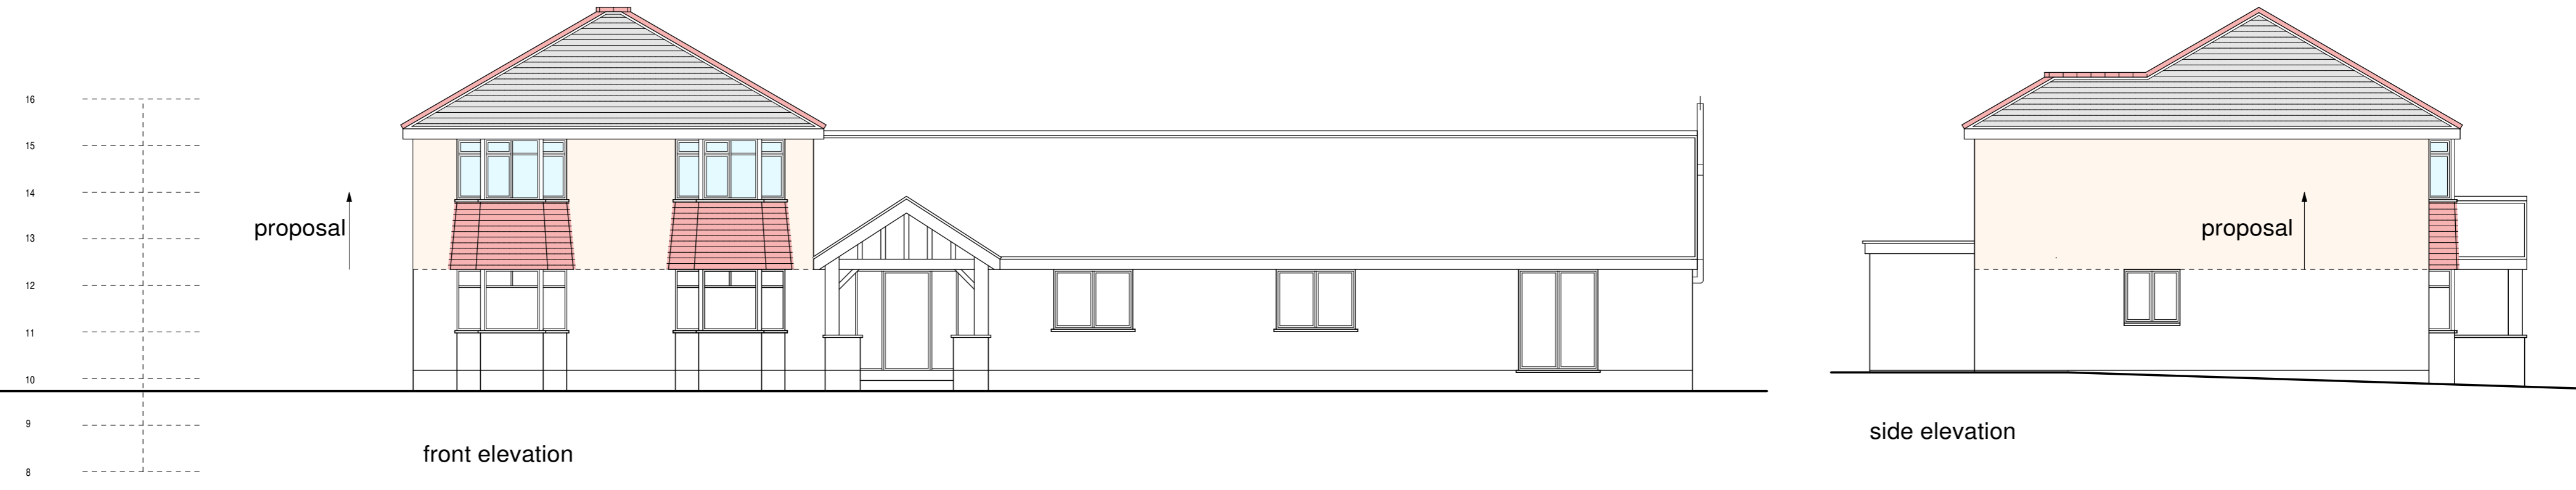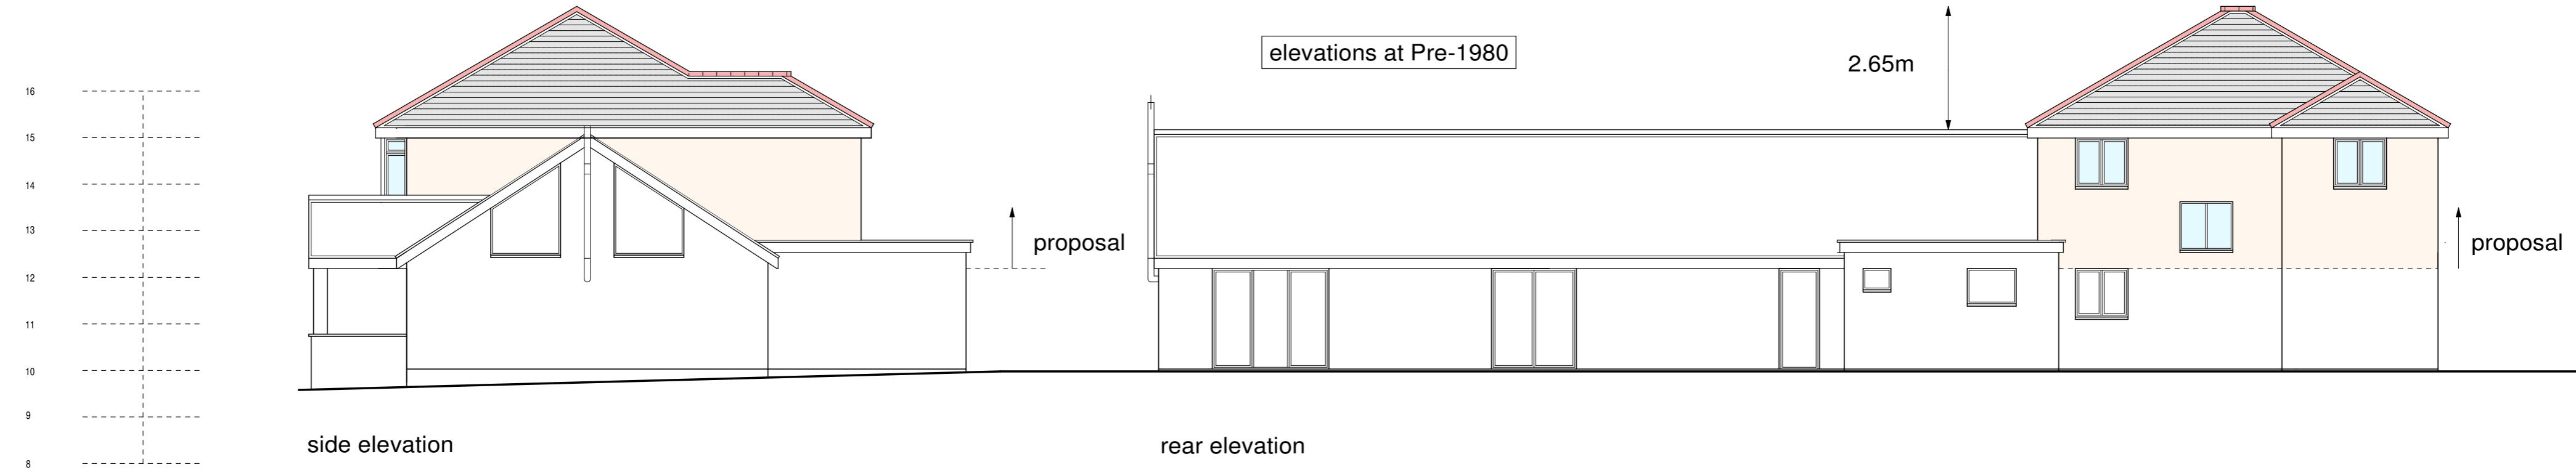

1:100 scale bar at A2

harriplan		
CORPORATE BUILDING ENGINEERS 23-25 ABBOTT ROAD, BOURNEMOUTH BH9 1EU. TEL. 01202 549590. FAX. 01202 522901		
E. Mail: jon@harriplan.com	JON HARRISON M.C.A.B.E.	

- NOTE:**
1. WORK TO FIGURED DIMENSIONS ONLY. DO NOT SCALE FROM DRAWINGS. SPECIFIC DIMENSIONS AVAILABLE ON REQUEST.
 2. NO THIRD PARTY LIABILITY IS GIVEN. SALE OF PROPERTY DOES NOT TRANSFER RIGHTS OF USE. AVAILABLE ON AGREEMENT.
 3. COPYRIGHT EXISTS ON ALL DRAWINGS. NO REPRODUCTION IN ANY FORM IS PERMITTED WITHOUT PRIOR CONSENT.
 4. ALL WORK COMMENCED PRIOR TO FORMAL BUILDING REGULATION AND / OR PLANNING APPROVAL IS ENTIRELY AT CONTRACTOR'S / CLIENT'S OWN RISK.
 5. CLIENTS TO BE AWARE OF THEIR RESPONSIBILITIES/LIABILITIES UNDER HEALTH & SAFETY LEGISLATION

DRAWN BY:	J.G.H.
DRAWING NO:	4419:A 7
DATE:	AUGUST 2024
SCALE:	1:100

PLAN OF:
ALTERATIONS TO ANCHOR PADDOCK,
BACHELORS LANE,
HOLT, Nr. WIMBORNE DORSET

(right to rise: elevations)

prior to works:




ground floor


as built:



ground floor

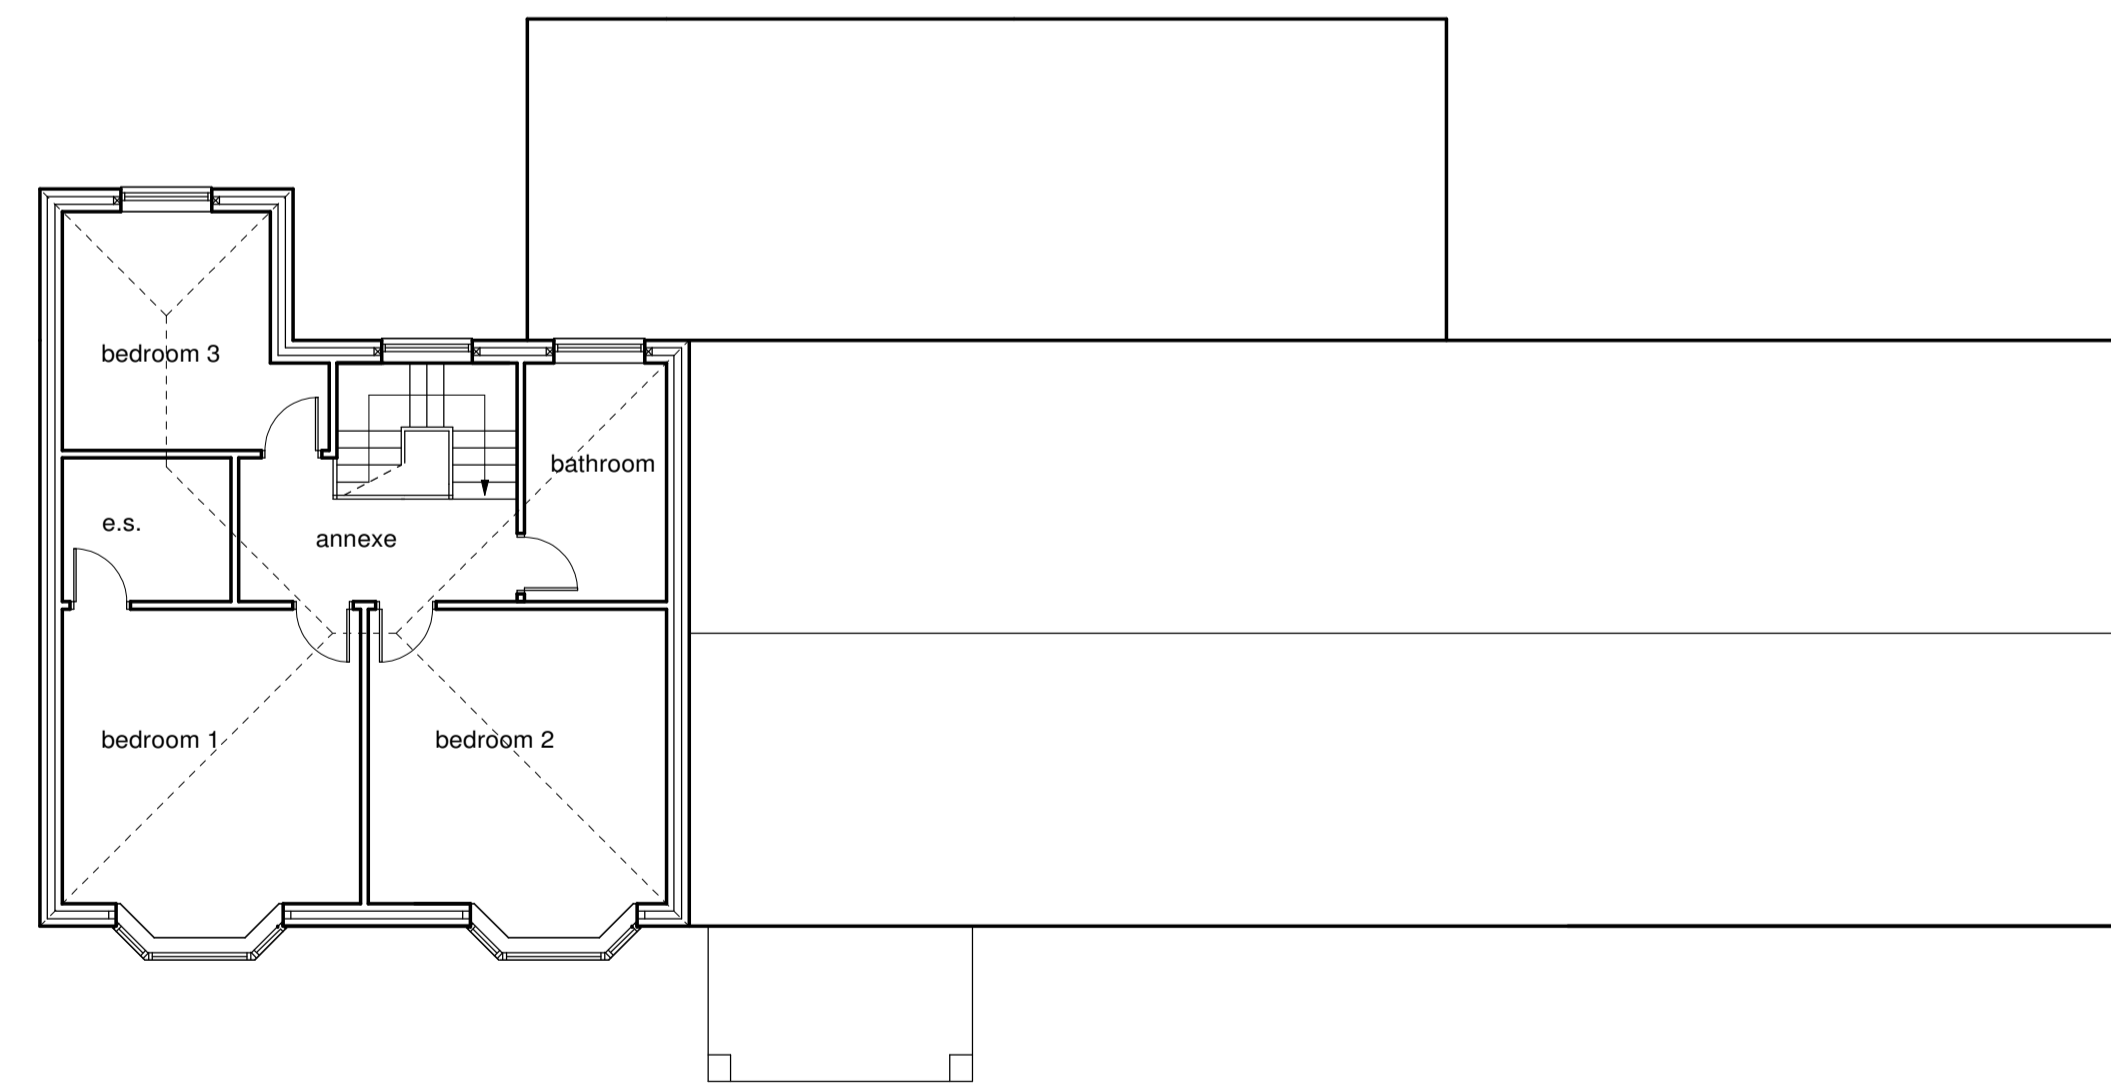

first floor

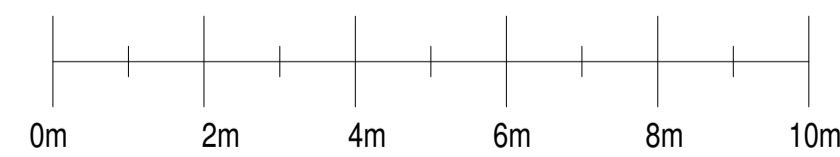

1:100 scale bar at A1

PLAN OF:
 ALTERATIONS TO ANCHOR PADDOCK,
 BACHELORS LANE,
 HOLT, Nr. WIMBORNE DORSET

(right to rise:existing and proposed)

DRAWN BY:	J.G.h.
DRAWING NO:	4419:A(5) RTR:1
DATE:	AUGUST 2024
SCALE:	1:100

NOTE:

1. WORK TO FIGURED DIMENSIONS ONLY. DO NOT SCALE FROM DRAWINGS. SPECIFIC DIMENSIONS AVAILABLE ON REQUEST.
2. NO THIRD PARTY LIABILITY IS GIVEN. SALE OF PROPERTY DOES NOT TRANSFER RIGHTS OF USE. AVAILABLE ON AGREEMENT.
3. COPYRIGHT EXISTS ON ALL DRAWINGS. NO REPRODUCTION IN ANY FORM IS PERMITTED WITHOUT PRIOR CONSENT.
4. ALL WORK COMMENCED PRIOR TO FORMAL BUILDING REGULATION AND / OR PLANNING APPROVAL IS ENTIRELY AT CONTRACTOR'S / CLIENT'S OWN RISK.
- 5.

harriplan

CHARTERED BUILDING ENGINEERS
 25 ABBOTT ROAD, CHARMINSTER
 BOURNEMOUTH BH9 1EU. TEL/FAX 01202 549 590

E-Mail: jon@harriplan.com JON HARRISON M.C.A.B.E.

