


prior to works:



as built:

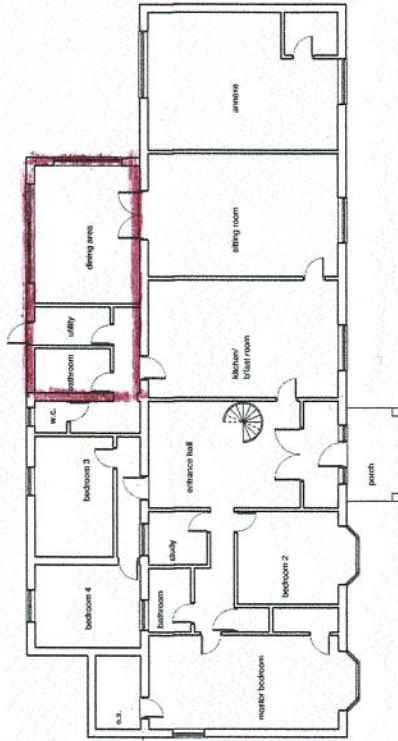


ground floor



1:100 scale bar at A1

first floor:

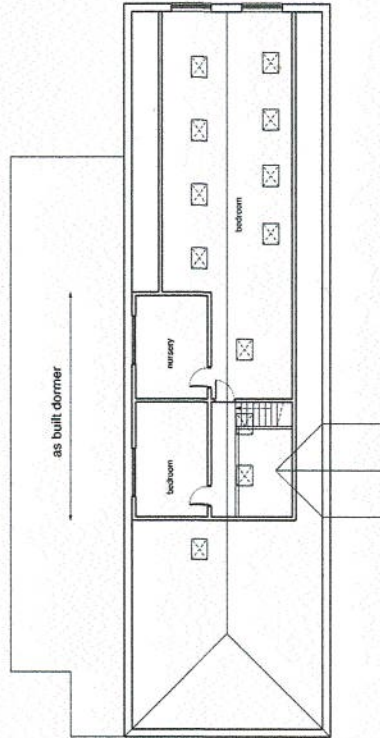

PLAN OF:  
 ALTERATIONS TO ANCHOR PADDOCK,  
 BACHELORS LANE,  
 HOLT, Nr. WIMBORNE DORSET  
 (as built alterations: floor plans)

DRAWN BY: J.G.h.  
 DRAWING NO: 4419A(3C)  
 DATE: FEBRUARY 2024  
 SCALE: 1:100

NOTE:  
 1. THIS DRAWING IS FOR INFORMATION ONLY. IT DOES NOT SCALE FROM DRAWINGS. PROTECT DIMENSIONS HAVE BEEN CHECKED.  
 2. NO THIRD PARTY LIABILITY IS GIVEN. SALE OF PROPERTY DOES NOT TRANSFER RESPONSIBILITY OF USE. AVAILABLE ON AGREEMENT.  
 3. ALL WORKS COMPLETED PRIOR TO COMMENCING BUILDING REGULATIONS AND OBTAINING APPROVALS. ENTIRELY AT CONTRACTOR'S OWN RISK.

**harriman**  
 CHARTERED BUILDING ENGINEERS  
 25 ABBOTT ROAD, CHARMINGFORD  
 BOURNEMOUTH BH9 1EG. TEL/FAX 01329 448 599  
 E. Mail: j.g.h@harriman.com JAVIMBERSON@CABE.BM

